

JACKSON
 P 2236
 5-28-76

MISSISSIPPI
 BOARD OF WATER COMMISSIONERS
 416 North State Street
 132 Jackson, Mississippi 39201

WATER WELL DRILLERS LOG

COAST WATER WELL SERVICE INC.

5/28 1976
 date well completed

firm name

Jackson
 county well located

LANDOWNER: Wayne Miron
600 River Oaks Drive
Hautier, Ms.
 (mailing address)

| description of formations encountered | from | to |
|---------------------------------------|------|-----|
| Top Soil | 0 | 2 |
| Blue Clay | 2 | 35 |
| Sand @ + Gravel | 35 | 100 |
| Blue Clay | 100 | 125 |
| Sand (C) | 125 | 146 |
| Blue Clay | 146 | 193 |
| Sand (med) | 193 | 282 |
| Blue Clay | 282 | 355 |
| Sand (med) | 355 | 387 |

WELL LOCATION:
 sec. 8 T. 7 S. R. 6 W.
 (distance) miles (direction) of (nearest town)
W Hautier

WELL PURPOSE: home
 (home, irrigation, municipal, industrial)

- WELL COMPLETION DATA:
- diameter (inches) 2"
 - total depth (feet) 387'
 - static water level (feet) 25' below top of ground
 - casing 2" (material) 377' (depth) cc
2" (size) if telescope see back.
 - screen 10' (length) 377' (depth to top)
2" (size) pvc (material)
 - pump 1 (HP) 9 1/2 (yield gpm)
Elec. (type power)
 - electric log No (yes or no)
 (organization running log)
 - how well bottom plugged b/w value


DRILLERS REMARKS:

RECEIVED
 JUN 28 1976

MISS. BD. OF WATER COMM

If well telescopes please sketch and show depths.

GROUND LEVEL

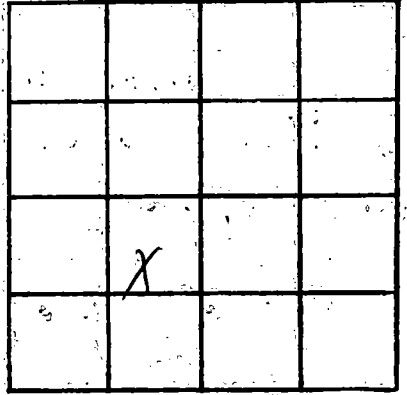

SECTION 8

Please indicate well location X.

ADDITIONAL INFORMATION



If more than one screen, show locations of each on sketch.