

JACKSON
P 2037
7/9/76

MISSISSIPPI
BOARD OF WATER COMMISSIONERS
416 North State Street
Jackson, Mississippi 39201

WATER WELL DRILLERS LOG

7/9 1976 Coast Water Well Serv Jackson
date well completed firm name county well located

LANDOWNER	description of formations encountered	from	to
Kiehl Curlee	top soil	0	5
713 Delapointe Dr.	blue clay	5	45
Hautier, Mrs. (mailing address)	grey coarse sand	45	102
WELL LOCATION: sec. 8 T. 8 R. 6 m. 5 Hautier	black clay	102	124
(distance) miles (direction) of (nearest town)	grey coarse sand	124	150
WELL PURPOSE: Home (home, irrigation, municipal, industrial)	blue clay	150	174
WELL COMPLETION DATA:	grey med sand	174	184
(1) diameter (inches) 2"	blue clay	184	190
(2) total depth (feet) 298'	fine grey sand	190	266
(3) static water level (feet) 31' below top of ground	coarse grey sand	266	298
(4) casing PVC, 288' (depth)			(toler)
2" (size) If telescope see back.			
(5) screen 10' (length), 288' (depth to top)			
2" (size), PVC (material)			
(6) pump 1 (HP), 8 (yield gpm)			
elec. (type power)			
(7) electric log NO (yes or no)			
(organization running log)			
(8) how well bottom plugged Blue Value			

RECEIVED


MAR - 9 1977

MISS. BD. OF WATER COMM

DRILLERS REMARKS:

If well telescopes please sketch and show depths.

GROUND LEVEL

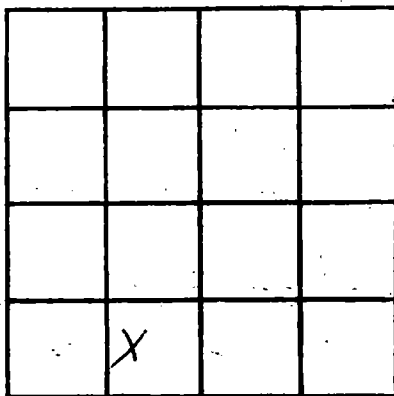

SECTION 8

Please indicate well location X.

ADDITIONAL INFORMATION

If more than one screen,
show locations of each on sketch.