

JACKSON  
P 2039  
10/8/76

MISSISSIPPI  
BOARD OF WATER COMMISSIONERS  
416 North State Street  
1302 Jackson, Mississippi 39201

WATER WELL DRILLERS LOG

10/8 date well completed 1976 Coast Water Well Serv. firm name Jackson county well located

LANDOWNER: A. D. Hrafton  
2034 Market St.  
Pascagoula Ms.  
(mailing address)

description of formations encountered	from	to
top soil	0	6
grey clay	6	20

WELL LOCATION:  
sec. 31 T. 7 S. R. 6 W.  
in Sautter  
miles (distance) of (direction) of (nearest town)

med. sand	20	31
grey clay	31	90
sand + gravel	90	150

WELL PURPOSE: Home  
(home, irrigation, municipal, industrial)

blue clay	150	179
-----------	-----	-----

WELL COMPLETION DATA:  
(1) diameter (inches) 2"  
(2) total depth (feet) 265'  
(3) static water level (feet) 25' <sup>below</sup> <sub>above</sub> top of ground.  
(4) casing PVC, 255' LL  
(material) (depth)  
2" If telescope see back.  
(size)  
(5) screen 10', 255'  
(length) (depth to top)  
2", PVC  
(size) (material)  
(6) pump 1 7 1/2  
(HP) (yield gpm)  
elec.  
(type power)  
(7) electric log NO  
(yes or no)  
(organization running log)  
(8) how well bottom plugged Alw Valve

sand - med. to coarse	179	265
		Hole


RECEIVED  
MAR - 9 1977

MISS. BD. OF WATER COMM

DRILLERS REMARKS:

If well telescopes please sketch and show depths.

GROUND LEVEL

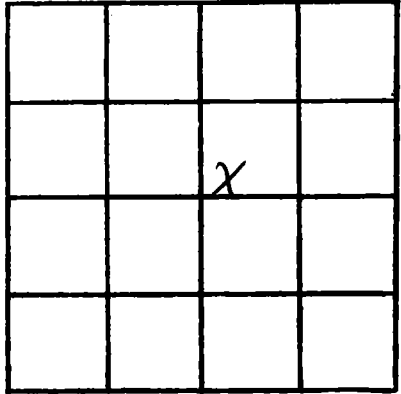

SECTION 31

Please indicate well location X.

ADDITIONAL INFORMATION

If more than one screen,  
show locations of each on sketch.