

JACKSON  
 P 7038  
 7/23/76

MISSISSIPPI  
 BOARD OF WATER COMMISSIONERS  
 416 North State Street  
 Jackson, Mississippi 39201

WATER WELL DRILLERS LOG


7/23 1976 COAST WATER WELL SERVICE INC. Jackson  
 date well completed firm name county well located

LANDOWNER:	description of formations encountered	from	to
Quinn Super Rt. 1 Box 144	top soil	0	5
Lucedale Ms. (mailing address)	blue clay	5	35
WELL LOCATION: sec. 8 T. 7 R. 6 in Gautier (distance) miles (direction) of (nearest town)	grey coarse sand + gravel	35	172
	blue clay	172	215
WELL PURPOSE: Home (home, irrigation, municipal, industrial)	grey coarse sand	215	299
WELL COMPLETION DATA:	grey coarse sand + gravel	299	304
(1) diameter (inches) 2"	blue clay	304	390
(2) total depth (feet) 455'	grey fine sand	390	401
(3) static water level (feet) 36 <sup>below</sup> <del>above</del> top of ground.	grey med. sand	401	413
(4) casing PVC 445' (material) (depth)	blue clay	413	435
2" (size) if telescope see back.	grey coarse sand	435	455
(5) screen 10' 445' (length) (depth to top)			H21e
2" (size) PVC (material)			
(6) pump (HP) (yield gpm)			
(type power)			
(7) electric log NO (yes or no)			
(organization running log)			
(8) how well bottom plugged B/w Value			
DRILLERS REMARKS:			

MAR - 9 1977  
 MISS. BD. OF WATER COMM

If well telescopes please sketch and show depths.

GROUND LEVEL

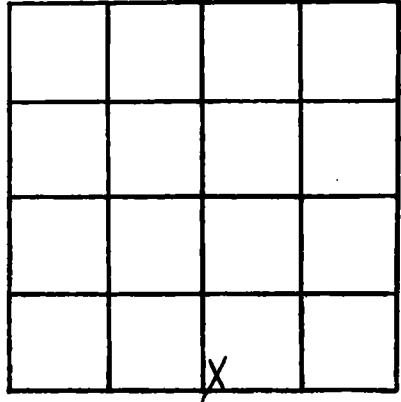

SECTION 8

Please indicate well location X.

ADDITIONAL INFORMATION

If more than one screen, show locations of each on sketch.