

**MISSISSIPPI
BOARD OF WATER COMMISSIONERS**
416 North State Street
Jackson, Mississippi 39201

WATER WELL DRILLERS LOG

JACKSON
P 2040
9-10-76


9/10 1976 Coast Water Well Ser. Jackson
date well completed firm name county well located

LANDOWNER: <u>R.D. Dawkins</u>	description of formations encountered	from	to
<u>3601 Garden Lane</u> <u>Gautier, Mo.</u> (mailing address)			
WELL LOCATION: sec. <u>31T 7</u> R. <u>6</u> <u>in Gautier</u> (distance) miles (direction) of (nearest town)	<u>top soil</u>	<u>0</u>	<u>8</u>
WELL PURPOSE: <u>Home</u> (home, irrigation, municipal, industrial)	<u>grey clay</u>	<u>8</u>	<u>58</u>
WELL COMPLETION DATA: (1) diameter (inches) <u>2"</u>	<u>sand - (c)</u>	<u>58</u>	<u>95</u>
(2) total depth (feet) <u>270'</u>	<u>blue clay</u>	<u>95</u>	<u>98</u>
(3) static water level (feet) <u>30'</u> ^{below} <u>above</u> top of ground.	<u>sand + gravel</u>	<u>98</u>	<u>112</u>
(4) casing <u>PVC</u> <u>260' c</u> (material) (depth)	<u>blue clay</u>	<u>112</u>	<u>138</u>
<u>2"</u> (size) if telescope see back.	<u>sand (c)</u>	<u>138</u>	<u>150</u>
(5) screen <u>10'</u> <u>260'</u> (length) (depth to top)	<u>Blue clay</u>	<u>150</u>	<u>196</u>
<u>2"</u> (size) <u>PVC</u> (material)	<u>sand - med to coarse</u>	<u>196</u>	<u>270</u>
(6) pump <u>—</u> <u>—</u> (HP) (yield gpm)			<u>total</u>
(type power)			
(7) electric log <u>NO</u> (yes or no)			
(organization running log)			
(8) how well bottom plugged <u>blue water</u>			
DRILLERS REMARKS:			

RECEIVED
MAR 8 1977
MISS. BD. OF WATER COMM

If well telescopes please sketch and show depths.

GROUND LEVEL

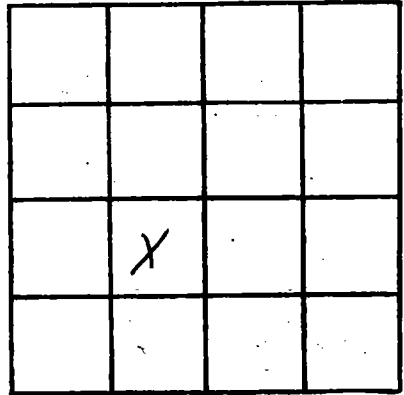

SECTION 31

Please indicate well location X.

ADDITIONAL INFORMATION

If more than one screen, show locations of each on sketch.