

JACKSON  
P 2092  
11/9/76

MISSISSIPPI  
BOARD OF WATER COMMISSIONERS  
416 North State Street  
13a Jackson, Mississippi 39201

WATER WELL DRILLERS LOG  
COAST WATER WELL SERVICE INC.

11/9 1976 date well completed  
firm name  
Jackson county well located

LANDOWNER: Mary Walker  
Fishing Camp  
Gautier, Miss. 39553  
(mailing address)

| description of formations encountered | from | to   |
|---------------------------------------|------|------|
| Top Soil                              | 0    | 2    |
| Gray Clay                             | 2    | 40   |
| Red Orange Sand                       | 40   | 60   |
| Blue Clay                             | 60   | 63   |
| Gray Coars Sand                       | 63   | 101  |
| Blue Clay                             | 101  | 192  |
| Gray Coars Sand                       | 192  | 325  |
| Blue Clay                             | 325  | 360  |
| Gray Med. + Fine Sand                 | 360  | 414  |
| Blue Clay                             | 414  | 420  |
| Blue Clay to Sand Shale               | 420  | 487  |
| Gray Fine Sand                        | 487  | 507  |
| Blue Clay                             | 507  | 540  |
| Blue Clay to Sand Shale               | 540  | 713  |
| Blue Clay to Sand Shale               | 713  | 736  |
| Blue Clay + Sand                      | 736  | 757  |
| Gray Coars Sand                       | 757  | 785  |
|                                       |      | Hole |

WELL LOCATION:  
sec. 31 T. 7 R. 6  
in Gautier  
(distance) miles (direction) of (nearest town)

WELL PURPOSE: Fishing Camp  
(home, irrigation, municipal, industrial)

- WELL COMPLETION DATA:
- diameter (inches) 3"
  - total depth (feet) 785
  - static water level (feet) 34 (below top of ground)
  - casing P.V.C. 767' c' (material) (depth)
  - screen 18' (length) 767' (depth to top)
  - pump 1 hp. 8 (HP) (yield gpm)
  - electric log No. (yes or no)
  - organization running log
  - how well bottom plugged P.W. blue


RECEIVED  
MAR - 9 1977

MISS. BD. OF WATER COMM

DRILLERS REMARKS:

If well telescopes please sketch and show depths.

GROUND LEVEL

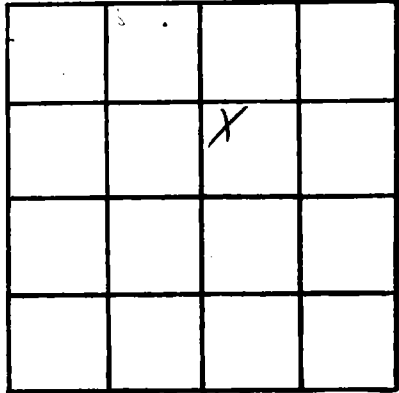

SECTION 31

Please indicate well location X.

ADDITIONAL INFORMATION

If more than one screen, show locations of each on sketch.