

JACKSON  
 P 2044  
 3/4/77

MISSISSIPPI  
 BOARD OF WATER COMMISSIONERS  
 416 North State Street  
 130 Jackson, Mississippi 39201

WATER WELL DRILLERS LOG

3-4 1977 Coast Water Well Serv. Jackson  
 date well completed firm name county well located

LANDOWNER: O. B. Johns  
Inters Rd.  
 Gautier, Ms.  
 (mailing address)

WELL LOCATION:  
 sec. 8 T. 7 N. R. 6 E  
in Gautier  
 (distance) miles (direction) of (nearest town)

WELL PURPOSE: home  
 (home, irrigation, municipal, industrial)

WELL COMPLETION DATA:  
 (1) diameter (inches) 2"  
 (2) total depth (feet) 400 ~~410~~  
 (3) static water level (feet) 25 <sup>below</sup> ~~above~~ top of ground.  
 (4) casing PVC, 400'  
 (material) (depth)  
2" If telescope see back.  
 (size)  
 (5) screen 10', 400'  
 (length) (depth to top)  
2", PVC  
 (size) (material)  
 (6) pump —, —  
 (HP) (yield gpm)  
—  
 (type power)  
 (7) electric log NO  
 (yes or no)  
—  
 (organization running log)  
 (8) how well bottom plugged B/w valve

description of formations encountered	from	to
<u>top soil</u>	<u>0</u>	<u>10</u>
<u>fine sand</u>	<u>10</u>	<u>15</u>
<u>blue clay</u>	<u>15</u>	<u>45</u>
<u>coarse sand + gravel</u>	<u>45</u>	<u>110</u>
<u>blue clay</u>	<u>110</u>	<u>120</u>
<u>med. sand</u>	<u>120</u>	<u>135</u>
<u>blue clay</u>	<u>135</u>	<u>220</u>
<u>fine to coarse sand</u>	<u>220</u>	<u>290</u>
<u>blue clay</u>	<u>290</u>	<u>389</u>
<u>coarse sand</u>	<u>389</u>	<u>410</u>
		<u>like</u>


**RECEIVED**  
 MAR 11 1977

MISS. BD. OF WATER

DRILLERS REMARKS:

If well telescopes please sketch and show depths.

GROUND LEVEL

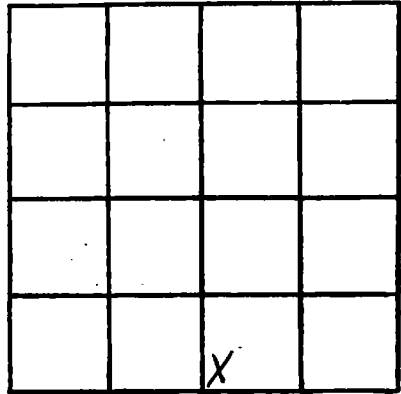

SECTION 8

Please indicate well location X.

ADDITIONAL INFORMATION

If more than one screen, show locations of each on sketch.