

Jackson
 P 2046
 5/11/77

MISSISSIPPI
 BOARD OF WATER COMMISSIONERS
 416 North State Street
 Jackson, Mississippi 39201

132

WATER WELL DRILLERS LOG

5-11-77
 date well completed

19 Coast Water Well Saw.
 firm name

Jackson
 county well located

LANDOWNER	description of formations encountered	from	to
Jesse E. Roe	Top soil	0	2
Roe Paper Co.	Grey clay	2	15
P.O. Box 548 - Gautier (mailing address) / Mer 39523	Sand gravel	15	71
	Blue clay	71	119
	Sand (m.)	119	144
	Blue clay	144	215
	Sand (m.)	215	278
			Not

WELL LOCATION:

sec. 31 T. 7 S. R. 6 E.
 in miles N. of Gautier
 (distance) (direction) (nearest town)

WELL PURPOSE: Home
 (home, irrigation, municipal, industrial)

WELL COMPLETION DATA:

- (1) diameter (inches) 2"
- (2) total depth (feet) well 278'
- (3) static water level (feet) 30' below top of ground
- (4) casing P.V.C., 268' cc
 (material) (depth)
- 2 (size) if telescope see back.
- (5) screen 10' 268
 (length) (depth to top)
- 2 P.V.C.
 (size) (material)
- (6) pump 1 hp. 8
 (HP) (yield gpm)
- Electric
 (type power)
- (7) electric log No
 (yes or no)

(organization running log)


(8) how well bottom plugged.
 back wash valve

DRILLERS REMARKS:

RECEIVED
 NOV - 7 1977

If well telescopes please sketch and show depths.

GROUND LEVEL

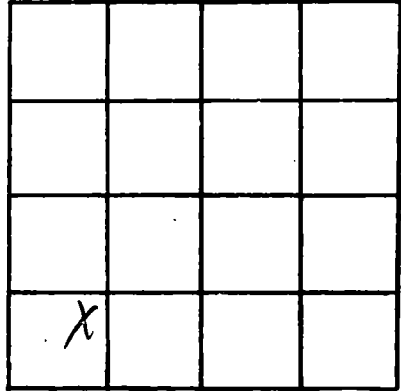

SECTION 31

Please indicate well location X.

ADDITIONAL INFORMATION

If more than one screen, show locations of each on sketch.