

Jackson
 P 2047
 10/8/77

MISSISSIPPI
 BOARD OF WATER COMMISSIONERS
 416 North State Street
 Jackson, Mississippi 39201

WATER WELL DRILLERS LOG

10-8-77 19 Cross Water Well Serv. Jackson
 date well completed firm name county well located

Paul Darden
 LANDOWNER
 Lawler Baptist Church
 July 90 -
 Lawler, Miss. 39533
 (mailing address)

description of formations encountered	from	to
Top soil	0	10
Med. sand	10	20
blue clay	20	70
Course sand	70	105
blue clay	105	150
fine sand	150	180
blue clay	180	200
fine to coarse sand	200	285
blue clay (shaly sand)	285	790
Med. sand	790	840
		181e

WELL LOCATION:
 sec. 31 T 7 S R 6 E
 in _____ miles (distance) of _____ (direction) of _____ (nearest town)

WELL PURPOSE: Supply (home, irrigation, municipal, industrial)

WELL COMPLETION DATA:
 (1) diameter (inches) 2"
 (2) total depth (feet) 840'
 (3) static water level (feet) 30' below top of ground.
 (4) casing P.V.C. 830' c (material) (depth)
 2" (size) If telescope see back.
 (5) screen 10' (length) 830' (depth to top)
 2" (size) P.V.C. (material)
 (6) pump L.I.P. 10 (HP) (yield gpm)
 Elec (type power)
 (7) electric log No. (yes or no)
 _____ (organization running log)


(8) How well bottom plugged
 back wash valve
 DRILLERS REMARKS:

RECEIVED
 JAN 17 1978

MISC. BD. OF WATER COMM.

If well telescopes please sketch and show depths.

GROUND LEVEL

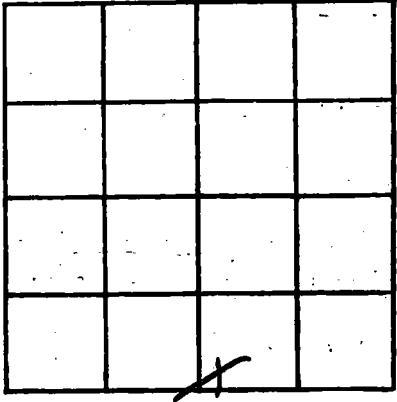

SECTION 31

Please indicate well location X.

ADDITIONAL INFORMATION

Lined area for additional information.

If more than one screen, show locations of each on sketch.