

JACKSON

P 2050

7-27-78

MISSISSIPPI BOARD OF WATER COMMISSIONERS  
416 North State Street  
Jackson, Mississippi 39201

WATER WELL DRILLERS LOG

7-27-78 date well completed 1978 Cash Water Well Sew. Inc. firm name Jackson county well located

LANDOWNER: Joe Luen  
P.O. Box 512  
Gautier, Miss 39553  
(mailing address)

WELL LOCATION:  
sec. 8 T 7 R 6 E  
3 S 1 P  
miles in of Gautier  
(distance) (direction) (nearest town)

WELL PURPOSE: Home  
(home, irrigation, mdnicipal, industrial)

WELL COMPLETION DATA:  
(1) diameter (inches) 2"  
(2) total depth (feet) well 90'  
(3) static water level (feet) 36' below top of ground.  
(4) casing PVC, 280' (material) (depth)  
2" If telescope see back. (size)  
(5) screen 10' 280' (length) (depth to top)  
2" PVC (size) (material)  
(6) pump L.H.P. 10 (HP) (yield gpm)  
Class. (type power)  
(7) electric log No. (yes or no)  
(organization running log)  
(8) how well bottom plugged Back wash Valve

description of fomations encountered	from	to
Top soil	0	2
Red Clay	2	12
Gray Coarse sand	12	68
Blue Clay	68	70
Gray Coarse sand	70	172
Blue Clay	172	200
Gray Coarse sand	200	290


RECEIVED  
NOV - 9 1978

MISS. BD. OF WATER COMM.

DRILLERS REMARKS:

If well telescopes please sketch and show depths.

GROUND LEVEL

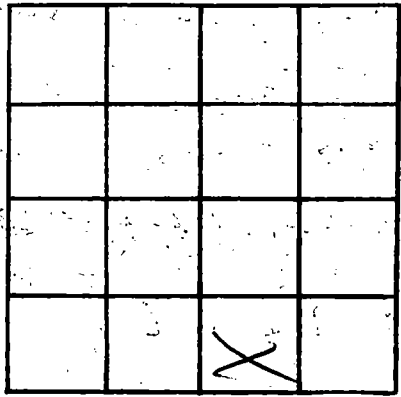

SECTION 8

Please indicate well location X.

ADDITIONAL INFORMATION

Lined area for additional information.

If more than one screen, show locations of each on sketch.