

JACKSON

P 2051

8-31-78

MISSISSIPPI BOARD OF WATER COMMISSIONERS 416 North State Street Jackson, Mississippi 39201

WATER WELL DRILLERS LOG

8-31-1978 East Water Well Service, Inc. Jackson date well completed firm name county well located

LANDOWNER: Walter Shaw

Rt 1 - Box 6 Gautier Miss (mailing address)

Table with 4 columns: description of formations encountered, from, to. Rows include Top Soil, Red Clay, Blue Clay, Gray Coarse sand & gravel, Blue Clay, Gray Coarse sand, Blue Clay, Gray Coarse sand.

WELL LOCATION:

sec 4 T 8 S R 6 E (distance) (direction) of Gautier (nearest town)


WELL PURPOSE: Home (home, irrigation, municipal, industrial)

WELL COMPLETION DATA:

- (1) diameter (inches) 2"
(2) total depth (feet) 306
(3) static water level (feet) 26' below top of ground
(4) casing PVC 296' (material) (depth) 2" (size) if telescope see back.
(5) screen 10' 296' (length) (depth to top) 2" PVC (size) (material)
(6) pump 1/2 hp 11.5 (HP) (yield gpm) Elect. (type power)
(7) electric log no (yes or no)
(organization running log)

(8) how well bottom plugged Back Wash Valve

DRILLERS REMARKS:

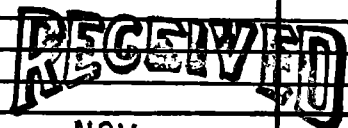

NOV - 9 1978

MISS. BD. OF WATER COMM

If well telescopes please sketch and show depths.

GROUND LEVEL

X			

SECTION 4

Please indicate well location: X.

**ADDITIONAL INFORMATION**

If more than one screen, show locations of each on sketch.