

JACKSON
 P 1053
 10-9-78

MISSISSIPPI
 BOARD OF WATER COMMISSIONERS
 416 North State Street
 Jackson, Mississippi 39201

WATER WELL DRILLERS LOG

10-9-78 date well completed
 1978 Coast Water Well Serv. Inc. firm name
 Jackson county well located

LANDOWNER	description of formations encountered	from	to
D. Kinard William 1715 Beach Blvd Pascagoula Miss. (mailing address)	Top soil	0	7
	Blue Clay + Campbell	7	50
	White Coarse sand	50	94
	Blue Clay	94	112
	White Coarse sand	112	150
	Blue Clay	150	156
	Gray Coarse sand	156	230
			Water

WELL LOCATION:
 sec. 8 T. 8 R. 6
 miles in direction of (nearest town)
 Pascagoula

WELL PURPOSE:
 (home, irrigation, municipal, industrial)
 Home

WELL COMPLETION DATA:
 (1) diameter (inches) 2"
 (2) total depth (feet) 230'
 (3) static water level (feet) 75' below top of ground.
 (4) casing PVC 220' (depth)
 2" (size) if telescope see back.
 (5) screen 10' (length) 220' (depth to top)
 2" (size) PVC (material)
 (6) pump 1/2 hp 6 (yield gpm)
 Electric (type power)
 (7) electric log No (yes or no)
 (organization running log)


(8) How well bottom plugged
 Back Wash Valve

DRILLERS REMARKS:

RECEIVED
 NOV 9 1978

If well telescopes please sketch and show depths.

GROUND LEVEL

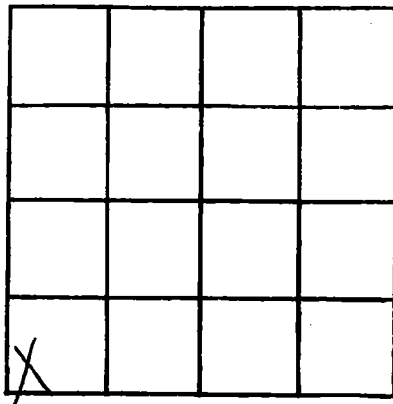

SECTION 8

Please indicate well location X.

ADDITIONAL INFORMATION

If more than one screen, show locations of each on sketch.