

JACKSON  
P 2055  
1-5-79

MISSISSIPPI  
BOARD OF WATER COMMISSIONERS  
416 North State Street  
Jackson, Mississippi 39201

WATER WELL DRILLERS LOG

1-5- date well completed    79 Coast Water Well Sew. Inc. firm name    Jackson county well located

LANDOWNER: Roger Jew  
313 Hwy. 90-  
Gretna, Miss. 39153  
(mailing address)

WELL LOCATION:  
sec 2 T 8 R 6  
5 W  
in miles (distance) of Gretna (direction) of Gretna (nearest town)

WELL PURPOSE: None  
(home, irrigation, municipal, industrial)

WELL COMPLETION DATA:  
(1) diameter (inches) 2"  
(2) total depth (feet) well 300  
(3) static water level (feet) 30' (below/above top of ground)  
(4) casing PVC 290' (material) (depth)  
2" (size) if telescope see back.  
(5) screen 10' 290' (length) (depth to top)  
2" (size) PVC (material)  
(6) pump 1 h.p. 9- (HP) (yield gpm)  
Elect. (type power)  
(7) electric log No. (yes or no)  
(organization running log)  
(8) flow well bottom plugged back wash valve

description of formations encountered	from	to
Top soil	0	5
Blue Clay	5	45
Sand - gravel	45	140
Blue Clay	140	145
Sand (C)	145	170
Blue Clay	170	180
Sand (C)	180	190
Blue Clay	190	210
Sand (C)	210	300
		Half

Miss. Board of Water Comm.


MAY 30 1979

RECEIVED

DRILLERS REMARKS:

If well telescopes please sketch and show depths.

GROUND LEVEL

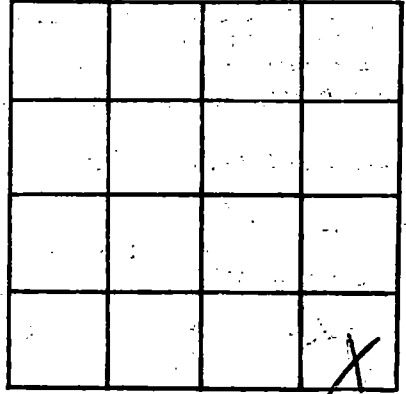

SECTION 2

Please indicate well location X.

ADDITIONAL INFORMATION

If more than one screen,  
show locations of each on sketch.