

JACKSON
 P 2056
 3-14-79

MISSISSIPPI
 BOARD OF WATER COMMISSIONERS
 416 North State Street
 Jackson, Mississippi 39201

WATER WELL DRILLERS LOG

3-14-1979 date well completed
 79 Cons & Water Well Drilling firm name
 Jackson county well located

LANDOWNER: M. A. Hollingsworth
 3305 Havill Rd
 Gautier, Miss. 39533
 (mailing address)

WELL LOCATION:
 sec. 31 T. 2 R. 6 S. W. of
 in miles (distance) of (direction) of (nearest town)

WELL PURPOSE: home
 (home, irrigation, municipal, industrial)

WELL COMPLETION DATA:
 (1) diameter (inches) 2"
 (2) total depth (feet) well 180'
 (3) static water level (feet) 25' below top of ground.
 (4) casing PVC, 270' (material) (depth)
 2" (size) If telescope see back.
 (5) screen 10' 270' (length) (depth to top)
 2" PVC (size) (material)
 (6) pump 1/2 hp. 8 (HP) (yield gpm)
 Elco (type power)
 (7) electric log No- (yes or no)
 (organization running log)
 (8) how well bottom plugged
 Back Wash Valve

description of formations encountered	from	to
	feet	feet
Sandy Top soil	0	8
Blue Clay	8	40
Sand (C)	40	80
Blue Clay	80	129
Sand (M)	129	140
Blue Clay	140	225
Sand (M)	225	280

DRILLERS REMARKS:


Miss. Board of Water

MAY 29 1979

RECEIVED

If well telescopes, please sketch and show depths.

GROUND LEVEL

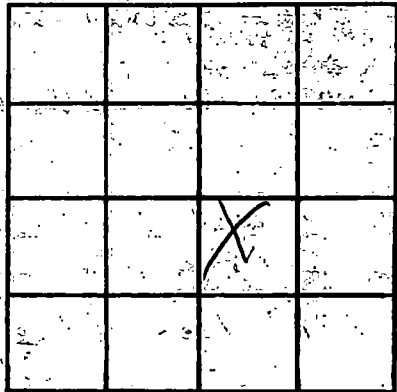

SECTION 31

Please indicate well location X.

ADDITIONAL INFORMATION

Multiple horizontal lines for additional information.

If more than one screen, show locations of each on sketch.