

JACKSON
 P 20 59
 10-25-79

MISSISSIPPI
 BOARD OF WATER COMMISSIONERS
 416 North State Street
 Jackson, Mississippi 39201

WATER WELL DRILLERS LOG

10-25-79 date well completed
 1979 Coast Water Well Dr. Inc. firm name
 Jackson county well located

LANDOWNER: James Tenley
P.O. Box 2066
Pascagoula, Miss. 39567
 (mailing address)

WELL LOCATION:
 sec. 2 T. 8 N. R. 6 E
9 miles (distance) of South (direction) of Levant (nearest town)

WELL PURPOSE: Home
 (home, irrigation, municipal, industrial)

WELL COMPLETION DATA:
 (1) diameter (inches) 2"
 (2) total depth (feet) well 557
 (3) static water level (feet) 25' ^{below} _{above} top of ground.
 (4) casing PVC 547' _(depth)
2" (size) if telescope see back.
 (5) screen 10' 547' _(length) _(depth to top)
2" (size) PVC (material)
 (6) pump 1 hp 9 _(HP) _(yield gpm)
Elec. (type power)
 (7) electric log No. (yes or no)
 (organization running log)

description of formations encountered	from	to
Top soil	0	4
Red Clay	4	10
Blue Clay	10	20
Gray Coarse sand	20	125-
Blue Clay	125	195-
Gray Coarse sand	195	295-
Gray Coarse sand + gravel	295	325-
Blue Clay + streak of sand	325	516
Gray med sand	516	529
Gray Coarse sand	529	557
		total

DEPT. OF NATURAL RESOURCES
 BUREAU OF LAND & WATER RESOURCES


FEB 26 1980

RECEIVED

(8) how well bottom plugged back wash valve
 DRILLERS REMARKS:

If well telescopes please sketch and show depths.

GROUND LEVEL

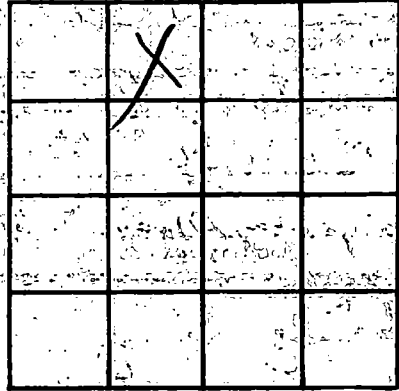

SECTION 7

Please indicate well location-X.

ADDITIONAL INFORMATION

Multiple horizontal lines for additional information.

If more than one screen, show locations of each on sketch.