

JACKSON

P 2060
1-29-80
1-29-80

MISSISSIPPI
BOARD OF WATER COMMISSIONERS
416 North State Street
Jackson, Mississippi 39201

WATER WELL DRILLERS LOG

date well completed 1-29-80 firm name Coast Water Well Sew. Inc. county well located Jackson

LANDOWNER: Patrick Gray Co. Inc.
1313 Pinecrest Ave.
Gulfport, Miss. 39501
(mailing address)

Description of formations encountered	from	to
Top soil + gray clay	0	18
White coarse sand	18	105
Blue clay	105	130
White coarse sand	130	160
blue clay	160	200
gray coarse sand	200	300
		Hole

WELL LOCATION:
sec. 31 T. 7 N. R. 10 E. S. 5
In Austin (distance) of (direction) (nearest town)

WELL PURPOSE: Home
(home, irrigation, municipal, industrial)

- WELL COMPLETION DATA:
- (1) diameter (inches) 2"
 - (2) total depth (feet) well 300'
 - (3) static water level (feet) 19' below above top of ground
 - (4) casing PVC, 290' CL (material) (depth)
 - 2" (size) if telescope see back.
 - (5) screen 10' (length), 290' (depth to top)
 - 2" PVC (size) (material)
 - (6) pump 1 hp. 8 (HP) (yield gpm)
 - Electric (type power)
 - (7) electric log No. (yes or no)

(organization running log)

(8) How well bottom plugged Pack wood valve

DRILLERS REMARKS:


DEPT. OF NATURAL RESOURCES
BUREAU OF LAND & WATER RESOURCES

JUL 2 1980

RECEIVED

If well telescopes please sketch and show depths.

GROUND LEVEL

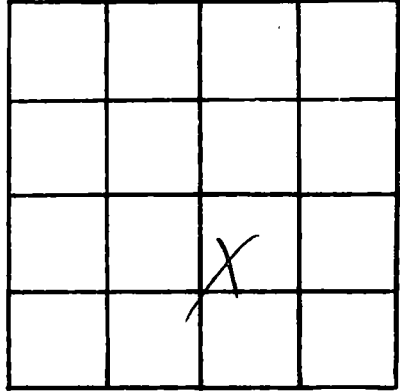

SECTION 31

Please indicate well location X.

ADDITIONAL INFORMATION

If more than one screen, show locations of each on sketch.