

JACKSON

P 7062
3-18-80
3-18-80

MISSISSIPPI
BOARD OF WATER COMMISSIONERS
416 North State Street
Jackson, Mississippi 39201

WATER WELL DRILLERS LOG

date well completed 3-18-80 firm name Coast States Well Serv Inc county well located Jackson

Pete White
OWNER: Gautier Oil Co.
P.O. Box 5,
Gautier, Miss. 39513
(mailing address)

| description of formations encountered | from | to |
|---------------------------------------|------------|--------------|
| <u>Topsoil + Red Clay</u> | <u>0</u> | <u>10</u> |
| <u>Blue Clay</u> | <u>10</u> | <u>52</u> |
| <u>White Coarse sand</u> | <u>-</u> | <u>-</u> |
| <u>Wood and gravel</u> | <u>52</u> | <u>195</u> |
| <u>Blue clay</u> | <u>195</u> | <u>253</u> |
| <u>Gray Coarse sand</u> | <u>253</u> | <u>310</u> |
| | | <u>Water</u> |

WELL LOCATION:
sec 8 N R 6 E
in Gautier
(distance) miles (direction) of (nearest town)

WELL PURPOSE: Comm
(home, irrigation, municipal, industrial)

WELL COMPLETION DATA:
(1) diameter (inches) 2"
(2) total depth (feet) well 310
(3) static water level (feet) 3' below above top of ground.
(4) casing PVC 300' CL
(material) (depth)
2" if telescope see back.
(size)
(5) screen 10' 300'
(length) (depth to top)
2" PVC
(size) (material)
(6) pump 1 HP -9-
(HP) (yield gpm)
Elect.
(type power)
(7) electric log No.
(yes or no)
(organization running log)

(8) how well bottom plugged
Backwash Valve

DRILLERS REMARKS:


DEPT. OF NATURAL RESOURCES
BUREAU OF LAND & WATER RESOURCES

JUL - 2 1980

RECEIVED

If well telescopes please
 sketch and show depths.

GROUND LEVEL

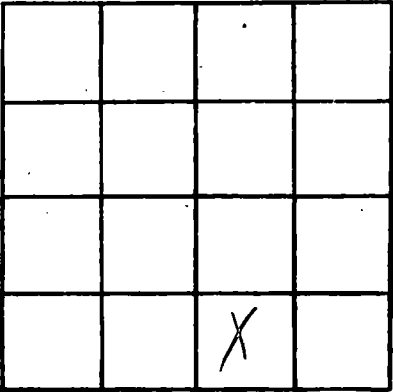

SECTION 24

Please indicate well location X.

ADDITIONAL INFORMATION

A series of horizontal lines for recording additional information.

If more than one screen,
 show locations of each on sketch.