

Jackson  
P 2064  
5-13-80

MISSISSIPPI  
BOARD OF WATER COMMISSIONERS  
416 North State Street  
Jackson, Mississippi 39201

WATER WELL DRILLERS LOG

3-29 19 date well completed  
Braden Pump + Well Service Inc firm name  
Jackson county well located


LANDOWNER: HAROLD KNIGHT 3209 Trondale Dr. Gautier, MS 39553 (mailing address)	description of formations encountered	from	to
WELL LOCATION: sec. 31 T. 7 S. R. 6 W. In Gautier (distance) (direction) (nearest town)	Clay	0	30
WELL PURPOSE: (home, irrigation, municipal, industrial)	Sand	30	145
WELL COMPLETION DATA: (1) diameter (inches) 4 x 2	Clay	145	200
(2) total depth (feet) 300'	Fine Sand	200	232
(3) static water level (feet) 60' below above top of ground.	Good Sand	232	300
(4) casing PVC, total 4 x 2 (material), (depth) (size) if telescope see back.			
(5) screen 10' 290 (length), (depth to top) 2" 008 PVC underbar (size), (material)			
(6) pump 1 15 (HP), (yield gpm) 230 (type power)			
(7) electric log NO (yes or no)			
(8) how well bottom plugged 2" sand shank			
DRILLERS REMARKS: no tail pipe			

DEPT. OF NATURAL RESOURCES  
BUREAU OF LAND & WATER RESOURCES

MAY 7 - 1980

RECEIVED

If well telescopes please sketch and show depths.

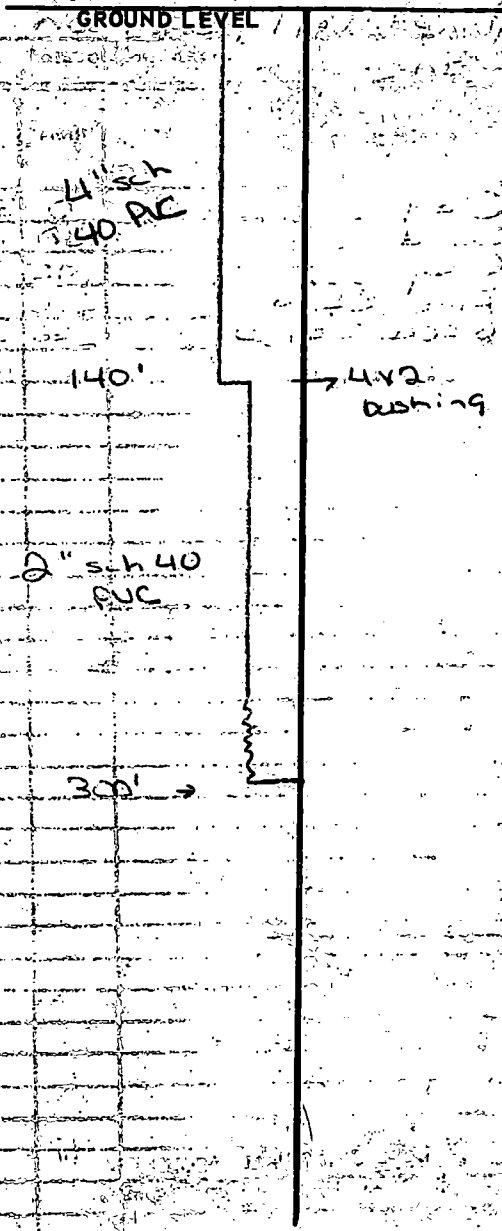

		X	

SECTION 31

Please indicate well location X.

ADDITIONAL INFORMATION

Blank lined area for additional information.

If more than one screen, show locations of each on sketch.