

JACKSON  
 P 2067  
 6-25-80

MISSISSIPPI  
 BOARD OF WATER COMMISSIONERS  
 416 North State Street  
 Jackson, Mississippi 39201



WATER WELL DRILLERS LOG

6-25-80 date well completed  
 Coast Water Well Service, Inc. firm name  
 Jackson county well located

LANDOWNER: Flora Thomas  
1625 Pat Drive  
Gautier, Miss.  
 (mailing address) 39113

description of formations encountered	from	to
Top Soil	0	3
Red Clay	3	10
Blue Clay	10	50
Gray Coarse Sand + Wood	50	107
Gray Coarse Sand	107	195
Blue Clay + Struck of sand	195	210
Gray Coarse Sand	210	300

WELL LOCATION:  
 L.G. sec 2 T 8 N R 6 E  
 In 0 miles (distance) of Gautier (direction) of Gautier (nearest town)

WELL PURPOSE: Home  
 (home, irrigation, municipal, industrial)

- WELL COMPLETION DATA:
- (1) diameter (inches) 2"
  - (2) total depth (feet) well 300'
  - (3) static water level (feet) 27' <sup>below</sup> <sub>above</sub> top of ground.
  - (4) casing P.V.C. (material), 290' (depth), 2" (size) if telescope see back.
  - (5) screen 10' (length), 290' (depth to top), 2" (size), P.V.C. (material)
  - (6) pump 1 (HP), 10 (yield gpm), elec. (type power)
  - (7) electric log NO (yes or no)

(organization running log)


(8) how well bottom plugged Backward valve

DRILLERS REMARKS:

DEPT. OF NATURAL RESOURCES  
 BUREAU OF LAND & WATER RESOURCES  
 MAR 20 1981  
 RECEIVED

If well telescopes please sketch and show depths:

GROUND LEVEL

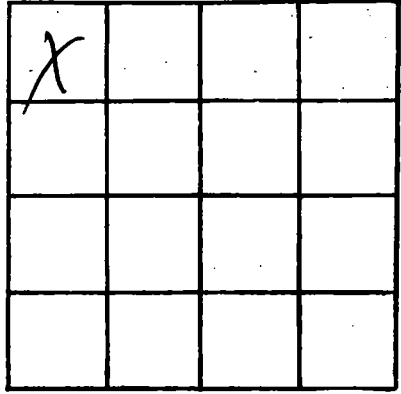

L.G. 2  
SECTION 2

Please indicate well location X.

ADDITIONAL INFORMATION

If more than one screen,  
show locations of each on sketch.