

JACKSON
P 2069
11-4-80

MISSISSIPPI
BOARD OF WATER COMMISSIONERS
416 North State Street
Jackson, Mississippi 39201

WATER WELL DRILLERS LOG

11-4 date well completed

80 Coach Water Well Sewer firm name

Jackson county well located

LANDOWNER

Eddie Smith

description of formations encountered

from

to

3425 Harold Rd.
Gautier, Miss. 39553
(mailing address)

Sandy Top soil

0 6'

Red clay

6 15'

Q Sandy + gravel

15 68'

Blue clay

68 210'

Q Sand + gravel

210 285'

WELL LOCATION:

sec. 31 T 7 N R 6 E
IN miles of GAUTIER
(distance) (direction) (nearest town)

WELL PURPOSE:

None (home, irrigation, municipal, industrial)

WELL COMPLETION DATA:

- (1) diameter (inches) 2"
- (2) total depth (feet) 285'
- (3) static water level (feet) 30' (below above top of ground)
- (4) casing PVC 22" OC (material) (depth)
- 2" (size) if telescope see back.
- (5) screen 10' 22" (length) (depth to top)
- 2" PVC (size) (material)
- (6) pump 1 hp. 10 (HP) (yield gpm)
- Electric (type power)
- (7) electric log No (yes or no)
- NA (organization running log)

(8) has well bottom plugged back wash valve


DRILLERS REMARKS:

DEPT. OF NATURAL RESOURCES
BUREAU OF LAND & WATER RESOURCES

APR - 6 1981
RECEIVED

If well telescopes please sketch and show depths.

GROUND LEVEL

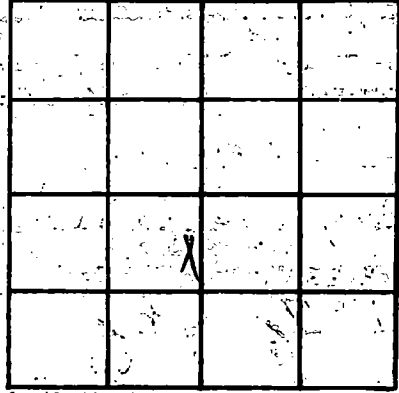

SECTION 31

Please indicate well location X.

ADDITIONAL INFORMATION

A series of horizontal lines for writing additional information.

If more than one screen, show locations of each on sketch.