

JACKSON
P 2070
11-24-80
11-24-80

MISSISSIPPI
BOARD OF WATER COMMISSIONERS
416 North State Street
Jackson, Mississippi 39201

WATER WELL DRILLERS LOG

date well completed

firm name

county well located

Cross Water Well Serv. Jackson

LANDOWNER:

Ray Foster
P.O. Box 1617
Pascagoula Miss.
(mailing address) 39567

description of formations encountered

from

to

Top soil	0	5'
Red Clay	5'	15'
Blue Clay	15'	21'
Blue Clay + Chert shell	21'	40'
Gray Coarse sand	40'	53'
Gray Coarse sand + wood	53'	100'
Gray Coarse sand + Gravel	100'	143'
Blue Clay	143'	148'
Blue Clay + Chert shell	148'	179'
Blue Clay	179'	210'
Gray Coarse sand	210'	322'
Blue Clay	322'	389'
Blue Clay + Shale + wood	389'	430'
Blue Clay	430'	450'
Gray fine sand	450'	489'
Blue Clay + 5" sand	489'	520'
Gray med. sand + wood	520'	578'
Blue Clay + Chert shell	578'	608'
Blue Clay + Chert shell	608'	690'
Gray Coarse sand	690'	734'

WELL LOCATION:

2 sec 8 T 8 R 6
1N miles of GAUSTEE
(distance) (direction) (nearest town)

WELL PURPOSE:

(home, irrigation, municipal, industrial)

WELL COMPLETION DATA:

- (1) diameter (inches) 2"
- (2) total depth (feet) well 734'
- (3) static water level (feet) 46' ^{below} top of ground
- (4) casing PDC 714' U
(material) (depth)
- 2" if telescope see back.
(size)
- (5) screen 20' 714'
(length) (depth to top)
- 2" PDC
(size) (material)
- (6) pump 1 hp 9
(HP) (yield gpm)
- Electric
(type power)
- (7) electric log No.
(yes or no)
- N/A
(organization running log)
- (8) How well bottom plugged
Backwash valve

DEPT OF NATURAL RESOURCES
STATE OF MISSISSIPPI
BOARD OF LAND & WATER RESOURCES


APR - 6 1981

DRILLERS REMARKS:

RECEIVED

If well telescopes please sketch and show depths.

GROUND LEVEL

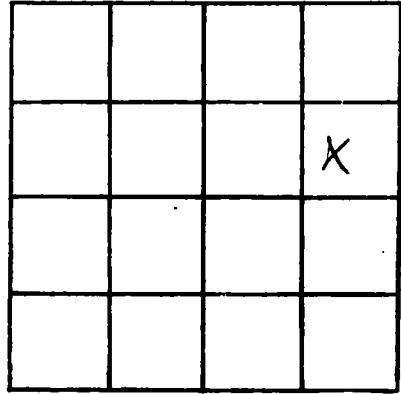

SECTION 9FG

Please indicate well location X.

ADDITIONAL INFORMATION

If more than one screen, show locations of each on sketch.