

MISSISSIPPI DEPARTMENT OF NATURAL RESOURCES

Bureau of Land and Water Resources

Southport Mall

P.O. Box 10631

Jackson, Mississippi 39209

WATER WELL DRILLERS LOG

JACKSON
P 2072
7-16-81

7-16-81 Coast Water Well Co. Jackson -
date well completed firm name county well located

LANDOWNER: B. B. Conner Co.
and or Jimmy Bishop.
312 Skoole Rd.
Pas. Miss, 39567
(mailing address)

WELL LOCATION:
sec. 31 T-7 N S R-6 E W
1N miles of GAUTIER
(distance) (direction) (nearest town)

WELL PURPOSE: Home
(home, irrigation, municipal, industrial)

- WELL COMPLETION DATA:
- (1) diameter (inches) 2"
 - (2) total depth (feet) 300'
 - (3) static water level (feet) 22' ^{below} _{above} top of ground
 - (4) casing PVC, 290' _{(material) (depth)}
 - 2" if telescope see back.
(size)
 - (5) screen 10', 290'
(length) (depth to top)
 - 2" PVC
(size) (material)
 - (6) pump 1 1/2 8
(HP) (yield gpm)
 - Elect.
(type power)
 - (7) electric log No.
(yes or no)
 - (organization running log)
 - (8) How well bottom plugged Backwash Valve

description of formations encountered	from	to
<u>Top Soil</u>	<u>0</u>	<u>12'</u>
<u>Gray Clay</u>	<u>12'</u>	<u>45"</u>
<u>B. Clay C. Sand</u>	<u>45'</u>	<u>90'</u>
<u>C. sand</u>	<u>90'</u>	<u>110'</u>
<u>B. Clay</u>	<u>110'</u>	<u>135'</u>
<u>C. Sand</u>	<u>135'</u>	<u>190'</u>
<u>B. Clay</u>	<u>190'</u>	<u>225'</u>
<u>C. sand</u>	<u>225'</u>	<u>300'</u>

DEPT. OF NATURAL RESOURCES
BUREAU OF LAND & WATER RESOURCES


AUG 14 1981

RECEIVED

DRILLERS REMARKS:

If well telescopes please sketch and show depths.

GROUND LEVEL

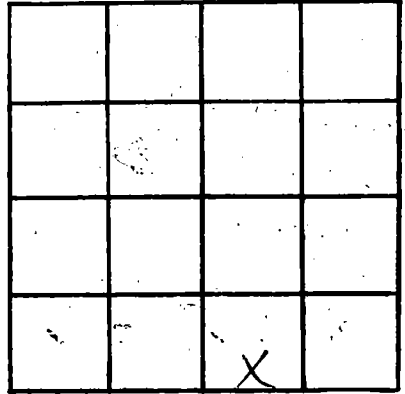

SECTION 31

Please indicate well location X.

ADDITIONAL INFORMATION

If more than one screen, show locations of each on sketch.