

MISSISSIPPI DEPARTMENT OF NATURAL RESOURCES

Bureau of Land and Water Resources

Southport Mall

P.O. Box 10631

Jackson, Mississippi 39209

WATER WELL DRILLERS LOG

JACKSON
P 2074
7-27-81

7-27-81 Coast Water Well Service, Jackson
 date well completed firm name county well located

LANDOWNER: Joe Polough
P.O. Box 249-
Gautier, Miss.
 (mailing address) 39513

description of formations encountered	from	to
<u>Top soil</u>	<u>0</u>	<u>10'</u>
<u>Blue clay & clam shell</u>	<u>10'</u>	<u>44'</u>
<u>White Mus. Sand</u>	<u>44'</u>	<u>65'</u>
<u>White Coarse Sand & Wood</u>	<u>65'</u>	<u>90'</u>

WELL LOCATION:
 sec. 8 T. 24 N. R. 6 E
IN miles of GAUTIER
 (distance) (direction) (nearest town)

WELL PURPOSE: Home
 (home, irrigation, municipal, industrial)

- WELL COMPLETION DATA:
- (1) diameter (inches) 2"
 - (2) total depth (feet) 90'
 - (3) static water level (feet) 18' ^{below} ~~above~~ top of ground.
 - (4) casing PVC, 85'
 (material) (depth)
2" if telescope see back.
 (size)
 - (5) screen 5ft, 85'
 (length) (depth to top)
2" PVC
 (size) (material)
 - (6) pump 1/2 hp.
 (HP) (yield gpm)
Electric
 (type power)
 - (7) electric log No
 (yes or no)
- (organization running log)

(8) how well bottom plugged
back wash valve

DRILLERS REMARKS:


DEPT. OF NATURAL RESOURCES
 BUREAU OF LAND & WATER RESOURCES

AUG 14 1981

RECEIVED

If well telescopes please sketch and show depths.

GROUND LEVEL

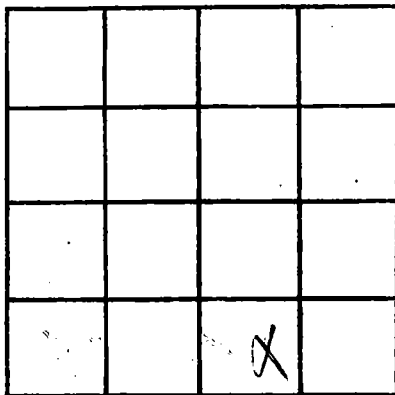

SECTION 8

Please indicate well location X.

ADDITIONAL INFORMATION

If more than one screen,
show locations of each on sketch.