

MISSISSIPPI DEPARTMENT OF NATURAL RESOURCES

Bureau of Land and Water Resources

Southport Mall

P.O. Box 10631

Jackson, Mississippi 39209

WATER WELL DRILLERS LOG

JACKSON  
P 2675  
7-15-81

7-15-81 date well completed  
Coxs Water Well Sew. Inc. firm name  
Jackson county well located

LANDOWNER: Taylor at Can Corp  
2302 Penny Ave  
Pascagoula Miss.  
(mailing address) 39133

Description of formations encountered	from	to
Top soil	0	5'
Blue Clay & Shale	5'	40'
Blue Clay & Shale	40'	60'
Gray Coarse sand & wood	60'	80'
Gray Coarse sand	80'	130'
Gray Coarse sand & wood	130'	140'
Gray Coarse sand	140'	172'

WELL LOCATION:  
sec 7 T 8 N R 6 E  
IN miles of PASCAGOULA  
(distance) (direction) (nearest town)

WELL PURPOSE: Indus.  
(home, irrigation, municipal, industrial)

- WELL COMPLETION DATA:
- (1) diameter (inches) 4"
  - (2) total depth (feet) 172'
  - (3) static water level (feet) 22' below top of ground above
  - (4) casing PVC 152' (material) (depth)  
4" (size) if telescope see back.
  - (5) screen 20' (length) 152' (depth to top)  
4" (size) PVC (material)
  - (6) pump 5 hp 60 gal. (HP) (yield gpm)  
Elec. (type power)
  - (7) electric log No. (yes or no)  
(organization running log)

(8) how well bottom plugged Backwash Valve

DRILLERS REMARKS:


DEPT. OF NATURAL RESOURCES  
BUREAU OF LAND & WATER RESOURCES

AUG 14 1981

RECEIVED

If well telescopes please sketch and show depths.

GROUND LEVEL

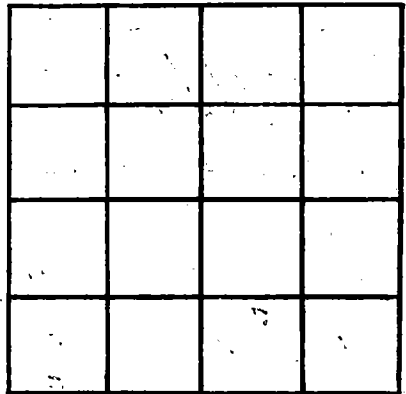

SECTION \_\_\_\_\_

Please indicate well location X.

ADDITIONAL INFORMATION

If more than one screen,  
show locations of each on sketch.