

MISSISSIPPI DEPARTMENT OF NATURAL RESOURCES

Bureau of Land and Water Resources

Southport Mall

P.O. Box 10631

Jackson, Mississippi 39209

WATER WELL DRILLERS LOG

JACKSON
P 2078
11-24-81

11-24-81 19
date well completed

Coast Water Well Sew. Jackson
firm name county well located

LANDOWNER E. J. Smith
Pascagoula
Miss.
(mailing address)

description of formations encountered	from	to
Top soil	0	2'
gray clay	2'	50'
C. sand	50'	90'

WELL LOCATION:
sec. 8 T 8 N R 6 E
IN miles (distance) of PASCAGOULA (direction) of (nearest town)

WELL PURPOSE: home
(home, irrigation, municipal, industrial)

- WELL COMPLETION DATA:
- (1) diameter (inches) 2"
 - (2) total depth (feet) 90'
 - (3) static water level (feet) 25' below top of ground. above
 - (4) casing PVC 50'
(material) (depth)
2" If telescope see back.
(size)
 - (5) screen 10' 80'
(length) (depth to top)
2" PVC
(size) (material)
 - (6) pump _____
(HP) (yield gpm)
(type power)
 - (7) electric log No
(yes or no)
(organization running log)
 - (8) how well bottom plugged
back wash valve

DEPT. OF NATURAL RESOURCES
BUREAU OF LAND & WATER RESOURCES


DEC 11 1981

RECEIVED

DRILLERS REMARKS:

If well telescopes please sketch and show depths.

GROUND LEVEL

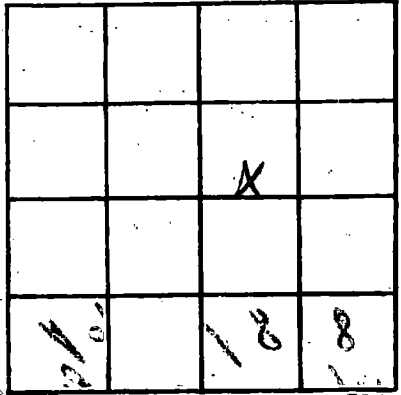

SECTION 8

Please indicate well location X.

ADDITIONAL INFORMATION

If more than one screen, show locations of each on sketch.