

MISSISSIPPI DEPARTMENT OF NATURAL RESOURCES
Bureau of Land and Water Resources
 Southport Mall
 P.O. Box 10631
 Jackson, Mississippi 39209
WATER WELL DRILLERS LOG

JACKSON
P2080
11-12-81

11-12-81 is Cross & Water Well Sew. Jackson
 date well completed firm name county well located

LANDOWNER: E. M. Alexander
P.O. Box 1161
Gautier, Miss.
 (mailing address) 39153

WELL LOCATION:
 sec. 8 T. 7 N. R. 6 E.
1/4 miles of GAUTIER
 (distance) (direction) (nearest town)

WELL PURPOSE: None
 (home, irrigation, municipal, industrial)

WELL COMPLETION DATA:
 (1) diameter (inches) 2"
 (2) total depth (feet) 280'
 (3) static water level (feet) 71' below
 top of ground.
 (4) casing PVC, 270'
 (material) (depth)
2" if telescope see back.
 (size)
 (5) screen 10', 270'
 (length) (depth to top)
2", PVC
 (size) (material)
 (6) pump 1 hp., 8
 (HP) (yield gpm)
Elect.
 (type power)
 (7) electric log No.
 (yes or no)
 (organization running log)

description of formations encountered	from	to
<u>Top soil</u>	<u>0</u>	<u>3'</u>
<u>Red Clay</u>	<u>3'</u>	<u>10'</u>
<u>Blue Clay</u>	<u>10'</u>	<u>50'</u>
<u>gray coarse sand</u>	<u>50'</u>	<u>75'</u>
<u>Blue clay</u>	<u>75'</u>	<u>85'</u>
<u>gray coarse sand & gravel</u>	<u>85'</u>	<u>150'</u>
<u>Blue Clay</u>	<u>150'</u>	<u>195'</u>
<u>gray coarse sand</u>	<u>195'</u>	<u>280'</u>

DEPT. OF NATURAL RESOURCES
 BUREAU OF LAND & WATER RESOURCES


DEC 11 1981
RECEIVED

(8) how well bottom plugged vacuum pack valve

DRILLERS REMARKS:

If well telescopes please sketch and show depths.

GROUND LEVEL

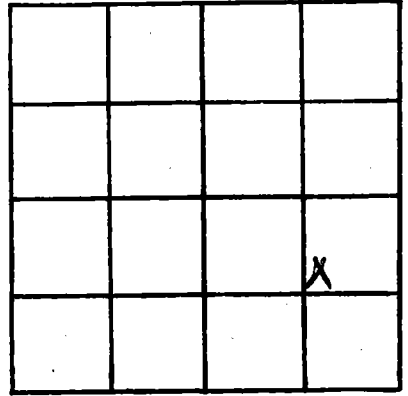

SECTION 8

Please indicate well location X.

ADDITIONAL INFORMATION

If more than one screen,
show locations of each on sketch.