

MISSISSIPPI DEPARTMENT OF NATURAL RESOURCES
Bureau of Land and Water Resources
 Southport Mall
 P.O. Box 10631
 Jackson, Mississippi 39209
WATER WELL DRILLERS LOG

P2081

12-23-81 19 Coastal Water Well Serv. Jackson.
 date well completed firm name county well located

LANDOWNER: D. W. Luke
P.O. Box 6461
Gulfport, Miss 395
 (mailing address)

description of formations encountered	from	to
<u>Top soil</u>	<u>0</u>	<u>5'</u>
<u>Red Clay</u>	<u>5'</u>	<u>19'</u>
<u>Blue Clay</u>	<u>19'</u>	<u>35'</u>
<u>White coarse sand & gravel</u>	<u>35'</u>	<u>99'</u>
<u>Blue Clay</u>	<u>99'</u>	<u>112'</u>
<u>Blue clay & wood</u>	<u>112'</u>	<u>117'</u>
<u>gray coarse sand</u>	<u>117'</u>	<u>300'</u>

WELL LOCATION:
 sec. 31 T. 7 S. R. 6 E.
1/4 miles (distance) N (direction) of Gautier (nearest town)

WELL PURPOSE: None
 (home, irrigation, municipal, industrial)

- WELL COMPLETION DATA:
- (1) diameter (inches) 2"
 - (2) total depth (feet) 300'
 - (3) static water level (feet) 24' ^{below} top of ground.
 - (4) casing PVC 290'
 (material) (depth)
2" If telescope see back.
 (size)
 - (5) screen 10' 290'
 (length) (depth to top)
2" PVC
 (size) (material)
 - (6) pump 1/2 hp. 6 1/2
 (HP) (yield gpm)
Elect.
 (type power)
 - (7) electric log No.
 (yes or no)
 (organization running log)
 - (8) how well bottom plugged Back wash valve

DRILLERS REMARKS:


DEPT. OF NATURAL RESOURCES
 BUREAU OF LAND & WATER RESOURCES

JAN 26 1982

RECEIVED

If well telescopes please sketch and show depths.

GROUND LEVEL

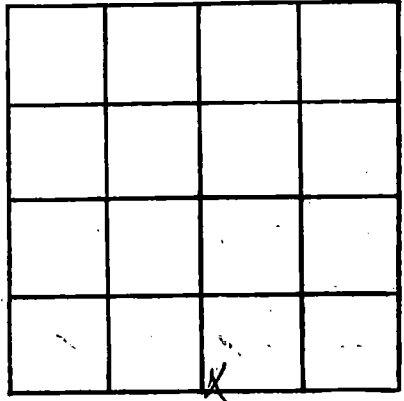

SECTION 31

Please indicate well location X.

ADDITIONAL INFORMATION

If more than one screen, show locations of each on sketch.