

MISSISSIPPI DEPARTMENT OF NATURAL RESOURCES

Bureau of Land and Water Resources

Southport Mall

P.O. Box 10631

Jackson, Mississippi 39209

WATER WELL DRILLERS LOG

Jackson
P2089

3-15-1982
date well completed

82 Coast Water Well Sew. Jackson
firm name county well located

LANDOWNER: Jasper Myers
425 Winddift Lane
Gautier, Miss. 39553
(mailing address)

description of formations encountered	from	to
Top soil	0	10'
Blue Clay	10	30'
Blue Clay & Shale	30'	70'
Gray Coarse sand	70'	107'
Gray Coarse sand & gravel	107'	144'
Blue Clay & Shale	144'	198'
Blue Clay	198'	210'
Gray Coarse sand	210'	314'
Blue Clay	314'	389'
Blue Clay & Shale	389'	450'
Gray fine sand	450'	489'
Blue Clay	489'	520'
Gray med sand	520'	575'
Blue Clay & Shale	575'	608'
Blue Clay	608'	680'
Blue fine sand	680'	706'
Gravel med sand	706'	728'
Gray Coarse sand	728'	750'

WELL LOCATION:

sec 8 T 8 S R 6 W
1.0 miles (distance) of GAUTIER (direction) (nearest town)

WELL PURPOSE: Home
(home, irrigation, municipal, industrial)

WELL COMPLETION DATA:

- (1) diameter (inches) 2"
- (2) total depth (feet) 750'
- (3) static water level (feet) 34' below top of ground
- (4) casing PVC (material), 730' (depth)
2" (size) If telescope see back.
- (5) screen 20' (length), 730' (depth to top)
2" (size), PVC (material)
- (6) pump 1 hp (HP), 9- (yield gpm)
Elect. (type power)
- (7) electric log No. (yes or no)

(organization running log)

(8) how well bottom plugged
Rock Wash Valve


DRILLERS REMARKS:

DEPT. OF NATURAL RESOURCES
BUREAU OF LAND & WATER RESOURCES

REC

If well telescopes please sketch and show depths.

GROUND LEVEL

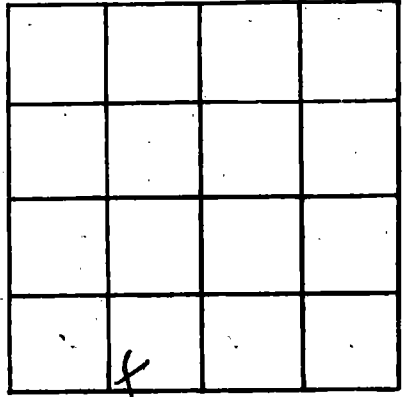

SECTION 9

Please indicate well location X.

ADDITIONAL INFORMATION

If more than one screen, show locations of each on sketch.