

MISSISSIPPI DEPARTMENT OF NATURAL RESOURCES

Bureau of Land and Water Resources

Southport Mall

P.O. Box 10631

Jackson, Mississippi 39209

WATER WELL DRILLERS LOG

Jackson
P2085

14

5-4-82 date well completed
 82 Cas Water Well Supte. Jackson firm name
 county well located

LANDOWNER: Douglas Gautier
 1600 Hi Way 90
 Gautier, Miss.
 (mailing address) 39553

WELL LOCATION:
 sec 4 T 8 N R 6 of
 IN miles of GAUTIER
 (distance) (direction) (nearest town)

WELL PURPOSE: Home
 (home, irrigation, municipal, industrial)

WELL COMPLETION DATA:

(1) diameter (inches) 2"
 (2) total depth (feet) 416'
 (3) static water level (feet) 45' below top of ground.
 (4) casing PVC 406" (depth)
 2" (size) If telescope see back.
 (5) screen 10' (length) 406' (depth to top)
 2" (size) PVC (material)
 (6) pump 1hp. 7 1/2 (yield gpm)
 (type power)
 (7) electric log 40- (yes or no)
 (organization running log)

description of formations encountered	from	to
Top soil	0	3'
Blue Clay	3'	10'
Gray Coarse sand	40'	53'
Blue Clay	53'	70'
Gray Coarse sand & wood	70'	117'
Blue Clay	117'	148'
Gray Coarse sand	148'	180'
Blue Clay	180'	216'
Gray Coarse sand	216'	321'
18" of rock		
Blue Clay	321'	392'
Gray Coarse sand	392'	416'

DEPT. OF NATURAL RESOURCES
 BUREAU OF LAND & WATER RESOURCES

JUN - 4 1982


RECEIVED

(8) How well bottom plugged
 back wash blue

DRILLERS REMARKS:

If well telescopes please sketch and show depths.

GROUND LEVEL

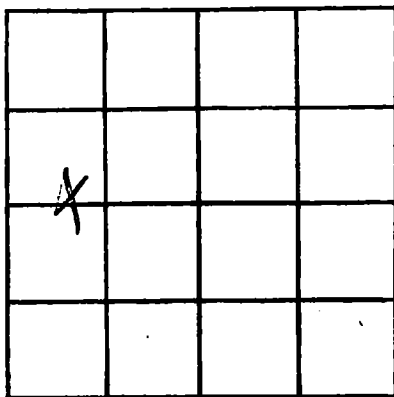

SECTION 9

Please indicate well location X.

ADDITIONAL INFORMATION

If more than one screen,
show locations of each on sketch.