

MISSISSIPPI DEPARTMENT OF NATURAL RESOURCES

Bureau of Land and Water Resources

Southport Mall

P.O. Box 10631

Jackson, Mississippi 39209

WATER WELL DRILLERS LOG

Jackson
P2086

5-17-

85 Coas Water Well Sew. Jackson

date well completed

firm name

county well located

LANDOWNER: Rachael Sma

description of formations encountered

from

to

Old Spanish Trail

Top soil

0 5'

Gautier miss.

Blue Clay

5' 30'

(mailing address) 375-53

WELL LOCATION:

sec. 2 T. 8 R. 6
N miles (distance) of GAUTIER (direction) (nearest town)

Q. Sand

30' 65'

WELL PURPOSE: Home
(home, irrigation, municipal, industrial)

WELL COMPLETION DATA:

- (1) diameter (inches) 2"
- (2) total depth (feet) 65'
- (3) static water level (feet) 19' below above top of ground.
- (4) casing PVC (material) 55' (depth)
- 2" (size) If telescope see back.
- (5) screen 10' (length) 55' (depth to top)
- 2" (size) PVC (material)
- (6) pump 1/2 hp (HP) 7 1/2 (yield gpm)
- (type power) _____
- (7) electric log No. (yes or no)

(organization running log)

(8) how well bottom plugged Back wash Valve

DEPT. OF NATURAL RESOURCES
BUREAU OF LAND & WATER RESOURCES


JUN - 4 1982

RECEIVED

DRILLERS REMARKS:

If well telescopes please
sketch and show depths.

GROUND LEVEL

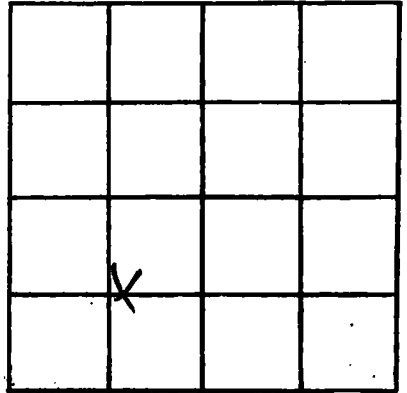

SECTION _____

Please indicate well location X.

ADDITIONAL INFORMATION

If more than one screen,
show locations of each on sketch.