

**MISSISSIPPI DEPARTMENT OF NATURAL RESOURCES**  
**Bureau of Land and Water Resources**  
 Southport Mall  
 P.O. Box 10631  
 Jackson, Mississippi 39209  
**WATER WELL DRILLERS LOG**

Jackson  
P2087

7-1- 1982 Coast Water Well Sew. Jackson  
 date well completed firm name county well located

LANDOWNER: Mr. Jack Hoover  
1112 Driftwood  
Pascagoula miss.  
 (mailing address) 39267

description of formations encountered	from	to
<u>Sand. Top soil</u>	<u>0</u>	<u>18'</u>
<u>S. Clay</u>	<u>18'</u>	<u>68'</u>
<u>O. Sand (S)</u>	<u>68'</u>	<u>90'</u>

WELL LOCATION:  
 sec. 8 T. 8 N. R. 6 E.  
1N miles (distance) of Pascagoula (nearest town)

WELL PURPOSE: Home  
 (home, irrigation, municipal, industrial)

WELL COMPLETION DATA:  
 (1) diameter (inches) 2"  
 (2) total depth (feet) 90  
 (3) static water level (feet) 22 <sup>below</sup> <sub>above</sub> top of ground.  
 (4) casing PVC 80'  
 (material) (depth)  
2" If telescope see back.  
 (size)  
 (5) screen 10' 80'  
 (length) (depth to top)  
2" PVC  
 (size) (material)  
 (6) pump 1hp. 8  
 (HP) (yield gpm)  
Elec.  
 (type power)  
 (7) electric log No.  
 (yes or no)  
 (organization running log)

(8) how well bottom plugged  
Back Wash Valve

DRILLERS REMARKS:


DEPT. OF NATURAL RESOURCES  
 BUREAU OF LAND & WATER RESOURCES

SEP -1 1982

**RECEIVED**

If well telescopes please sketch and show depths.

GROUND LEVEL

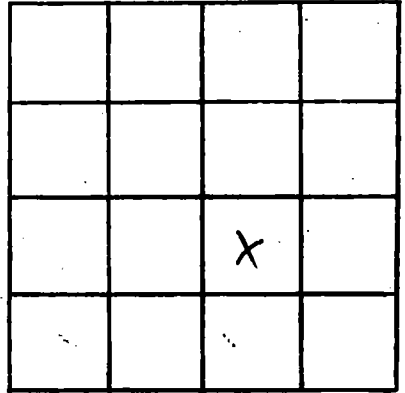

SECTION 8

Please indicate well location X.

ADDITIONAL INFORMATION

If more than one screen, show locations of each on sketch.