

MISSISSIPPI DEPARTMENT OF NATURAL RESOURCES

Bureau of Land and Water Resources

Southport Mall

P.O. Box 10631

Jackson, Mississippi 39209

WATER WELL DRILLERS LOG

Jackson  
P 2088

8-27-82 19 Coast Water Well Sew. Jackson  
date well completed firm name county well located

LANDOWNER: H.P. Herdelbaugh description of formations encountered from to

Pascagoula Mini. sandy top soil 0 10  
(mailing address) 3567 grey clay 10 55  
Coarse sand 55 85

WELL LOCATION:

sec. 6 T. 8 S. R. 6 W.  
1W miles of PASCAGOULA  
(distance) (direction) (nearest town)

WELL PURPOSE: home  
(home, irrigation, municipal, industrial)

WELL COMPLETION DATA:

- (1) diameter (inches) 4"
- (2) total depth (feet) 85'
- (3) static water level (feet) 25' <sup>below</sup> above top of ground.
- (4) casing PVC, 75'  
(material) (depth)  
4"  
(size) If telescope see back.
- (5) screen 10', 75'  
(length) (depth to top)  
4", PVC  
(size) (material)
- (6) pump 1, 15  
(HP) (yield gpm)  
ELECT.  
(type power)
- (7) electric log NO  
(yes or no)

(organization running log)

(8) how well bottom plugged Back  
wash valve

DRILLERS REMARKS:


DEPT. OF NATURAL RESOURCES  
BUREAU OF LAND & WATER RESOURCES

SEP 30 1982

RECEIVED

If well telescopes please sketch and show depths.

GROUND LEVEL

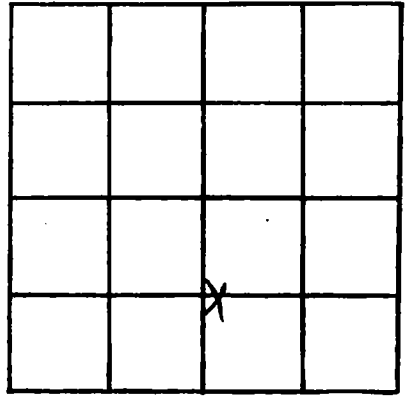

SECTION 6

Please indicate well location X.

ADDITIONAL INFORMATION

If more than one screen, show locations of each on sketch.