

MISSISSIPPI DEPARTMENT OF NATURAL RESOURCES

Bureau of Land and Water Resources

Southport Mall

P.O. Box 10631

Jackson, Mississippi 39209

WATER WELL DRILLERS LOG

Jackson  
F1091

12-6-82 to - 82 Coast Water Well in Jackson  
 date well completed firm name county well located

LANDOWNER: Charles M. Shepard II  
 1325 Grove line Rd.  
 Gautier, Miss.  
 (mailing address) 37553

description of formations encountered	from	to
Sandy Top soil	0	12'
A. Clay	12'	76'
C. Sand	76'	104'
B. Clay	104'	135'
C. Sand	135'	161'
B. Clay	161'	240'
C. Sand	240'	300'

WELL LOCATION:  
 sec 4 T 8 S R 7 E  
 IN miles (distance) of GAUTIER (nearest town)

WELL PURPOSE: Home  
 (home, irrigation, municipal, industrial)

- WELL COMPLETION DATA:
- (1) diameter (inches) 2"
  - (2) total depth (feet) 300'
  - (3) static water level (feet) 35' <sup>below</sup> <sub>above</sub> top of ground.
  - (4) casing PVC, 290' (material) (depth)  
 2" (size) If telescope see back.
  - (5) screen 10' (length) 290' (depth to top)  
 2" (size) PVC (material)
  - (6) pump 1 hp. - 9- (HP) (yield gpm)  
 Elec. (type power)
  - (7) electric log No. (yes or no)  
 (organization running log)

(8) how well bottom plugged  
 Back Wash Valve

DRILLERS REMARKS:


DEPT. OF NATURAL RESOURCES  
 BUREAU OF LAND & WATER RESOURCES

JAN 11 1983

RECEIVED

If well telescopes please  
sketch and show depths.

GROUND LEVEL

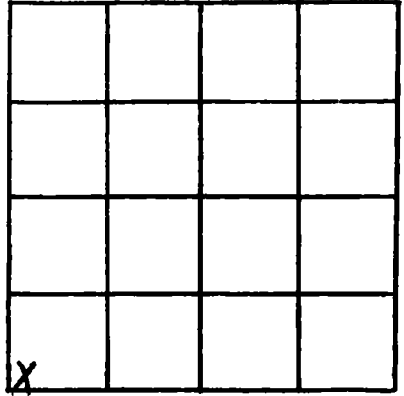

SECTION 4

Please indicate well location X.

ADDITIONAL INFORMATION

If more than one screen,  
show locations of each on sketch.