

MISSISSIPPI DEPARTMENT OF NATURAL RESOURCES

Bureau of Land and Water Resources

Southport Mall

P.O. Box 10631

Jackson, Mississippi 39209

WATER WELL DRILLERS LOG

Jackson
P2093

12-1-82 19 *Coast Water Well Sew.* *Jackson*
date well completed firm name county well located

LANDOWNER: *Ralph D. Kempf*
3106 Conty St.
Pascagoula, Miss
(mailing address) *39567*

description of formations encountered	from	to
<i>Top soil</i>	<i>0</i>	<i>10'</i>
<i>Blue Clay & Caplin Shell & wood</i>	<i>10'</i>	<i>70'</i>
<i>Gray coarse sand</i>	<i>70'</i>	<i>144'</i>
<i>Blue Clay & Struck of sand</i>	<i>144'</i>	<i>210'</i>
<i>Gray coarse sand</i>	<i>210'</i>	<i>311'</i>
<i>Blue Clay</i>	<i>311'</i>	<i>389'</i>
<i>Blue Clay & Shrubford</i>	<i>389'</i>	<i>426'</i>
<i>Blue Clay</i>	<i>426'</i>	<i>454'</i>
<i>Blue Clay & Struck sand</i>	<i>454'</i>	<i>471'</i>
<i>Gray fine sand</i>	<i>471'</i>	<i>482'</i>
<i>Blue Clay</i>	<i>482'</i>	<i>500'</i>
<i>Blue Clay & Caplin Shell</i>	<i>500'</i>	<i>690'</i>
<i>Gray med sand</i>	<i>690'</i>	<i>708'</i>
<i>Gray coarse sand</i>	<i>708'</i>	<i>744'</i>

WELL LOCATION:
sec. 2 T 8 S R 6 E
IN miles *---* of *GAULTIER*
(distance) (direction) (nearest town)

WELL PURPOSE: *Home*
(home, irrigation, municipal, industrial)

WELL COMPLETION DATA:

(1) diameter (inches) *2"*

(2) total depth (feet) *744'*

(3) static water level (feet) *40* below above top of ground.

(4) casing *PVC*, *724'*
(material) (depth)
(size) if telescope see back.

(5) screen *20'*, *724'*
(length) (depth to top)
2", *PVC*
(size) (material)

(6) pump *10 p.p.*, *8 1/2*
(HP) (yield gpm)
Electric
(type power)

(7) electric log *No.*
(yes or no)
(organization running log)

(8) *how well bottom plugged*
back wash valve

<i>Blue Clay</i>	<i>311'</i>	<i>389'</i>
<i>Blue Clay & Shrubford</i>	<i>389'</i>	<i>426'</i>
<i>Blue Clay</i>	<i>426'</i>	<i>454'</i>
<i>Blue Clay & Struck sand</i>	<i>454'</i>	<i>471'</i>
<i>Gray fine sand</i>	<i>471'</i>	<i>482'</i>
<i>Blue Clay</i>	<i>482'</i>	<i>500'</i>
<i>Blue Clay & Caplin Shell</i>	<i>500'</i>	<i>690'</i>
<i>Gray med sand</i>	<i>690'</i>	<i>708'</i>
<i>Gray coarse sand</i>	<i>708'</i>	<i>744'</i>

DEPT. OF NATURAL RESOURCES
BUREAU OF LAND & WATER RESOURCES


JAN 11 1983

RECEIVED

DRILLERS REMARKS:

If well telescopes please sketch and show depths.

GROUND LEVEL

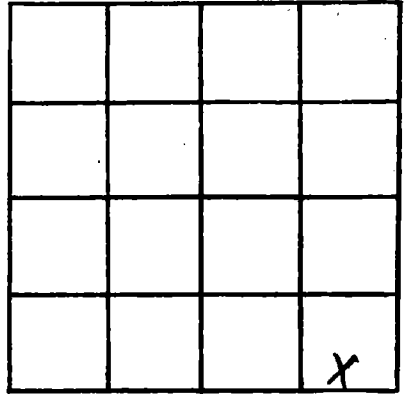

SECTION _____

Please indicate well location X.

ADDITIONAL INFORMATION

If more than one screen, show locations of each on sketch.