

Southport Mall

P.O. Box 10631

Jackson, Mississippi 39209

WATER WELL DRILLERS LOG

Jackson
Jul 27 1983

RECEIVED

6-28-83 date well completed
83. Cross Water Well Sew. firm name
Jackson county well located

LANDOWNER

Clason Hooker

description of formations encountered

from to

312 Hwy 90 West

Top soil

0 2'

Gautier, Miss.

Gray clay

2 15'

(mailing address) 89553

Blue Clay & Chalk

15 60

WELL LOCATION:

sec. 8 T 7 N R 6 E
IN miles (distance) of GAUTIER (direction) (nearest town)

Blue Clay & chalk

60 80'

WELL PURPOSE:

Home

White coarse sand & wood

80 107'

WELL COMPLETION DATA:

(1) diameter (inches) 2"

blue clay

107 150'

(2) total depth (feet) 430'

White coarse sand

150 173'

(3) static water level (feet) 69' below top of ground.

blue clay

173 223'

(4) casing PVC 420' (material) (depth)

Gray coarse sand

223 312'

2" (size) If telescope see back.

blue clay

312 390'

(5) screen 10' 420' (length) (depth to top)

Gray med sand

390 425'

2" PVC (size) (material)

blue clay

425 430'

(6) pump 1 hp (HP) 8 (yield gpm)

Chick (type power)

(7) electric log Yes (yes or no)


(organization running log)

(8) how well bottom plugged Backwash Valve

DRILLERS REMARKS:

If well telescopes please sketch and show depths.

GROUND LEVEL

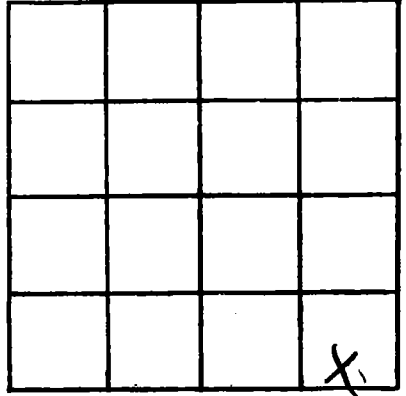

SECTION 8

Please indicate well location X.

ADDITIONAL INFORMATION

If more than one screen, show locations of each on sketch.