

Jackson
P 2099

MISSISSIPPI DEPARTMENT OF NATURAL RESOURCES
Bureau of Land and Water Resources
Southport Mall
P.O. Box 10631
Jackson, Mississippi 39209
WATER WELL DRILLERS LOG

7-1 1983 Coast Water Well Sew. Jackson
date well completed firm name county/well located

LANDOWNER: J. D. McQueen
81052 Hwy 63,
Ocean Springs, Miss.
(mailing address) 32567

WELL LOCATION:
sec. 1 T. 7 N. R. 6 E. W.
1 miles N of ESCATAWAMP
(distance) (direction) (nearest town)

WELL PURPOSE: Home
(home, irrigation, municipal, industrial)

WELL COMPLETION DATA:
(1) diameter (inches) 2"
(2) total depth (feet) 387'
(3) static water level (feet) 55' below top of ground.
(4) casing PVC 377' (material) (depth)
2" (size) If telescope see back.
(5) screen 10' 377' (length) (depth to top)
2" PVC (size) (material)
(6) pump 1/2 HP 8 (HP) (yield gpm)
Elec. (type power)
(7) electric log No. (yes or no)
(organization running log)
(8) How well bottom plugged.
Pack wash Valve.

Description of formations encountered	from	to
Top soil	0	2'
Red clay	2'	10'
Blue Clay	10'	40'
White Coarse sand & gravel	40'	119'
Blue Clay & streak of sand	119'	194'
White Coarse sand & wood	194'	205'
Blue Clay	205'	260'
Gray fine sand & wood	260'	280'
Blue Clay	280'	362'
Gray Coarse sand	362'	377'
Blue Clay	377'	387'

DEPT. OF NATURAL RESOURCES
BUREAU OF LAND & WATER RESOURCES


SEP 21 1983

RECEIVED

DRILLERS REMARKS:

If well telescopes please sketch and show depths.

GROUND LEVEL

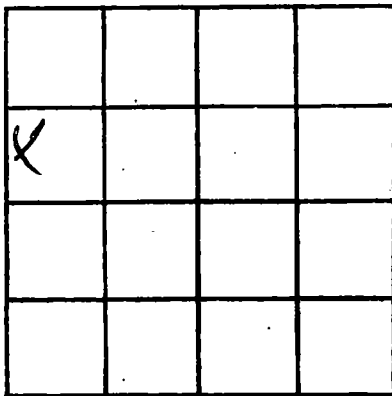

SECTION 2

Please indicate well location X.

ADDITIONAL INFORMATION

If more than one screen, show locations of each on sketch.