

MISSISSIPPI DEPARTMENT OF NATURAL RESOURCES

Bureau of Land and Water Resources

Southport Mall

P.O. Box 10631

Jackson, Mississippi 39209

WATER WELL DRILLERS LOG

Jackson  
P  
2100

7-22 1983 Anyala Well Sew Jackson  
date well completed firm name county well located

LANDOWNER: DONALD Sebastian  
316 Grauline Rd  
Ocean Springs MS 39553  
(mailing address)

WELL LOCATION:  
sec. 2 T. 2 N. R. 6 E.  
4 miles W of Ocean Springs  
(distance) (direction) (nearest town)

WELL PURPOSE:  
(home, irrigation, municipal, industrial)

WELL COMPLETION DATA:

- (1) diameter (inches) 2"
- (2) total depth (feet) 300' well
- (3) static water level (feet) 18' below above top of ground.
- (4) casing PVC, 300'  
(material) (depth)
- \_\_\_\_\_ If telescope see back.  
(size)
- (5) screen 20', 280 cc  
(length) (depth to top)
- fg, PVC  
(size) (material)
- (6) pump 3/4, 10  
(HP) (yield gpm)
- \_\_\_\_\_ (type power)
- (7) electric log \_\_\_\_\_  
(yes or no)
- \_\_\_\_\_ (organization running log)
- (8) how well bottom plugged \_\_\_\_\_

description of formations encountered	from	to
Topsoil + sand	0	40
CLAY	40	60
SAND	60	75
CLAY	75	95
SAND	95	120
CLAY	120	180
SAND	180	190
CLAY	190	210
SAND	210	300

1-to 1/2

DEPT. OF NATURAL RESOURCES  
BUREAU OF LAND & WATER RESOURCES


NOV - 7 1983

RECEIVED

DRILLERS REMARKS:

If well telescopes please sketch and show depths.

GROUND LEVEL

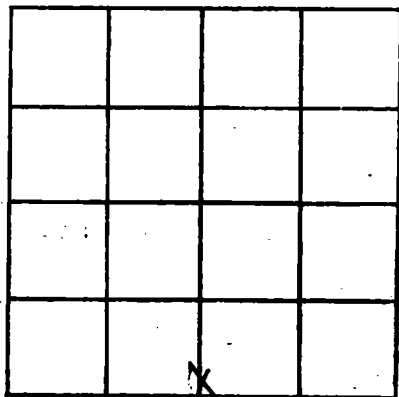

SECTION 2

Please indicate well location X.

ADDITIONAL INFORMATION

If more than one screen, show locations of each on sketch.