

MISSISSIPPI DEPARTMENT OF NATURAL RESOURCES

Bureau of Land and Water Resources

Southport Mall

P.O. Box 10631

Jackson, Mississippi 39209

WATER WELL DRILLERS LOG

Jackson  
P 2102

8-16-1983 date well completed  
Coast Water Well Serv. firm name  
Jackson county well located

LANDOWNER: W.R. Jarchald

800 North Wood Dr.  
Hattiesburg, Miss.  
(mailing address) 39564

WELL LOCATION:  
sec 8 T 7 N R 6 E  
1 N miles of GAULTIER  
(distance) (direction) (nearest town)

WELL PURPOSE: Home  
(home, irrigation, municipal, industrial)

WELL COMPLETION DATA:

- (1) diameter (inches) 2
- (2) total depth (feet) 435
- (3) static water level (feet) 61 (below top of ground)
- (4) casing PVC 425' (material) (depth)
- 2" (size) If telescope see back.
- (5) screen 10' 425' (length) (depth to top)
- 2" PVC (size) (material)
- (6) pump (HP) (yield gpm)
- (7) electric log No (yes or no)
- (organization running log)

(8) how well bottom plugged  
Back wash valve

DRILLERS REMARKS:


| description of formations encountered | from | to  |
|---------------------------------------|------|-----|
| Top soil                              | 0    | 5'  |
| Red Clay                              | 5'   | 18' |
| Blue Clay & Oyster Shells             | 18'  | 43' |
| Blue Clay                             | 43'  | 62  |
| White coarse sand                     | 62'  | 107 |
| White coarse sand & gravel            | 107  | 130 |
| Blue Clay                             | 130' | 200 |
| Gray coarse sand                      | 200' | 293 |
| Blue Clay                             | 293  | 390 |
| Gray fine sand                        | 390  | 408 |
| Gray med sand                         | 408  | 425 |
| Blue Clay                             | 425  | 435 |

DEPT. OF NATURAL RESOURCES  
BUREAU OF LAND & WATER RESOURCES

SEP 21 1983  
RECEIVED

If well telescopes please sketch and show depths.

GROUND LEVEL

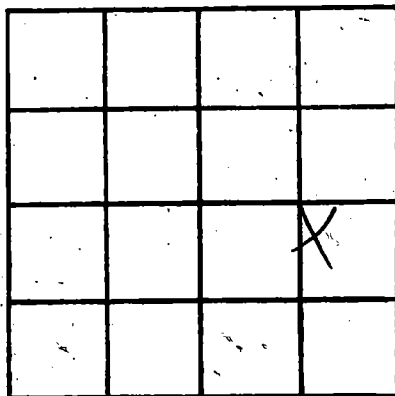

SECTION 8

Please indicate well location X.

ADDITIONAL INFORMATION

If more than one screen, show locations of each on sketch.