

MISSISSIPPI DEPARTMENT OF NATURAL RESOURCES

Bureau of Land and Water Resources

Southport Mall

P.O. Box 10631

Jackson, Mississippi 39209

WATER WELL DRILLERS LOG

JACKSON

P 2105

4-16-81 date well completed

St. Charles Water Well Service, Jackson firm name

Jackson county well located

LANDOWNER:

Leach, Inc.

description of formations encountered

from

to

Gautier, Miss.

Top soil

0 2'

39553

Red Clay

2' 11'

(mailing address)

WELL LOCATION:

sec 2 T 8 N R 6 S GAUTIER (distance) miles (direction) of (nearest town)

Blue Clay

11' 40'

White Crane sand and gravel

40' 183'

WELL PURPOSE: Home (home, irrigation, municipal, industrial)

Blue Clay

183' 200'

WELL COMPLETION DATA:

Gray Coarse sand 200' 299'

(1) diameter (inches) 2" (2) total depth (feet) 299' (3) static water level (feet) 29' below top of ground

(No. Tail Pipe)

(4) casing PVC 289' (material) (depth) 2" (size) If telescope see back.

(5) screen 10' 289' (length) (depth to top) 2" PVC (size) (material)

(6) pump 1/2 HP 10 (type power) (yield gpm)

(7) electric log No (yes or no) (organization running log)

(8) How well bottom plugged Back Wash Valve

DRILLERS REMARKS:


DEPT. OF NATURAL RESOURCES BUREAU OF LAND & WATER RESOURCES

JUL 10 1981

RECEIVED

If well telescopes please sketch and show depths.

GROUND LEVEL

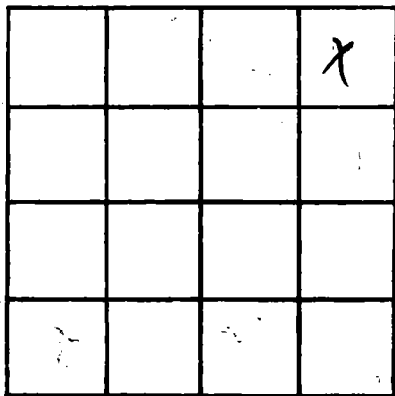

			X

SECTION 2

Please indicate well location X.

ADDITIONAL INFORMATION

If more than one screen,  
show locations of each on sketch.