

MISSISSIPPI DEPARTMENT OF NATURAL RESOURCES

Bureau of Land and Water Resources

Southport Mall

P.O. Box 10631

Jackson, Mississippi 39209

WATER WELL DRILLERS LOG

JACKSON  
A9101

4-23

date well completed

St Coast Water Well Sew.

firm name

Jackson

county well located

LANDOWNER:

Sam James

description of formations encountered

from

to

812 Ali Place

Top Soil

0' 3'

Gautier, Miss.

Red Clay

3' 10'

(mailing address) 39565

WELL LOCATION:

sec 2 T 8 S R 6 E

Gray Clay

10' 22'

IN miles (distance) of GAUTIER (direction) (nearest town)

Blue Clay

22' 29'

WELL PURPOSE: Home (home, irrigation, municipal, industrial)

Red Coarse Sand

29' 57'

WELL COMPLETION DATA:

(1) diameter (inches) 2"

(2) total depth (feet) 57'

(3) static water level (feet) 19' below top of ground

(4) casing PVC, 52' (material), (depth)

2" (size) If telescope see back.

(5) screen 5', 52' (length), (depth to top)

2" PVC (size), (material)

(6) pump (HP), (yield gpm)

(7) electric log No (yes or no)

(organization running log)

(8) how well bottom plugged Backwash Valve

DRILLERS REMARKS:


DEPT. OF NATURAL RESOURCES  
BUREAU OF LAND & WATER RESOURCES

JUL 10 1984

RECEIVED

If well telescopes please sketch and show depths.

GROUND LEVEL

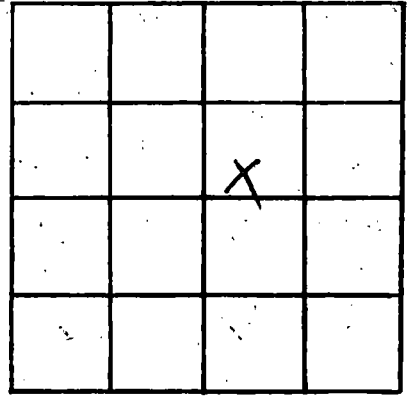

SECTION 2

Please indicate well location X.

ADDITIONAL INFORMATION

If more than one screen,  
show locations of each on sketch.