

MISSISSIPPI DEPARTMENT OF NATURAL RESOURCES

Bureau of Land and Water Resources

Southport Mall

P.O. Box 10631

Jackson, Mississippi 39209

WATER WELL DRILLERS LOG

JACKSON
P2107

5-11 1984
date well completed

24 Coast water well serv Jackson
firm name county well located

LANDOWNER: <u>What River Marine</u>	Description of formations encountered	from	to
<u>217 Lussac line Rd.</u>	<u>Top Soil</u>	<u>0</u>	<u>2</u>
<u>Gautier, Miss.</u> (mailing address) <u>325-13</u>	<u>Black Clay</u>	<u>2</u>	<u>16</u>
WELL LOCATION: sec. <u>2</u> T. <u>8</u> N. R. <u>6</u> E. <u>1N</u> miles (distance) (direction) of <u>GAUTIER</u> (nearest town)	<u>Blue Clay</u>	<u>16</u>	<u>40</u>
WELL PURPOSE: (home, irrigation, municipal, industrial)	<u>Brown Coarse Sand & Wood</u>	<u>40</u>	<u>60</u>
WELL COMPLETION DATA:	<u>Blue Clay</u>	<u>60</u>	<u>69</u>
(1) diameter (inches) <u>2"</u>	<u>Red Coarse Sand</u>	<u>69</u>	<u>110</u>
(2) total depth (feet) <u>301' to 91'</u>	<u>Red Coarse Sand & gravel</u>	<u>110</u>	<u>164'</u>
(3) static water level (feet) <u>30'</u> below top of ground	<u>Blue Clay</u>	<u>164</u>	<u>177</u>
(4) casing <u>PVC</u> , <u>281'</u> (material) (depth)	<u>White Coarse Sand</u>	<u>177</u>	<u>195</u>
<u>2"</u> (size) If telescope see back.	<u>Blue Clay</u>	<u>195</u>	<u>217</u>
(5) screen <u>10'</u> , <u>281'</u> (length) (depth to top)	<u>Gray Med. Sand</u>	<u>217</u>	<u>236</u>
<u>2"</u> (size), <u>PVC</u> (material)	<u>Gray Coarse Sand</u>	<u>236</u>	<u>291</u>
(6) pump _____ (HP) _____ (yield gpm)	<u>Gray Coarse Sand -</u>		
(type power) _____	<u>Wood & Gravel</u>	<u>291</u>	<u>301</u>
(7) electric log <u>NO</u> (yes or no)	<u>281</u>		<u>Hole</u>
(organization running log)	<u>10' x 2"</u>		
(8) how well bottom plugged <u>Backwash valve</u>	<u>10' x 2"</u>		

MISSISSIPPI DEPARTMENT OF NATURAL RESOURCES
BUREAU OF LAND AND WATER RESOURCES


JUL 10 1984

DRILLERS REMARKS:

RECEIVED

If well telescopes please sketch and show depths.

GROUND LEVEL

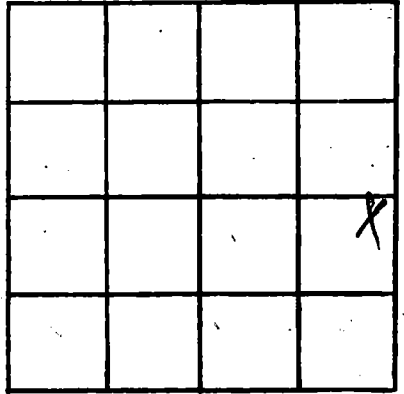

SECTION 2

Please indicate well location X.

ADDITIONAL INFORMATION

If more than one screen, show locations of each on sketch.