

MISSISSIPPI DEPARTMENT OF NATURAL RESOURCES

Bureau of Land and Water Resources

Southport Mall

P.O. Box 10631

Jackson, Mississippi 39209

WATER WELL DRILLERS LOG

P Jackson  
PHD

10-4-84 19 Cash Water Well Sew. Jackson  
date well completed firm name county well located

LANDOWNER: W. Runnels  
P.O. Box 1927  
Pascagoula, Miss  
(mailing address) 39567

description of formations encountered	from	to
<u>Black Top Soil</u>	<u>0</u>	<u>3'</u>
<u>Coarse Sand</u>	<u>3'</u>	<u>18'</u>
<u>Blue Clay</u>	<u>18'</u>	<u>50'</u>
<u>Med. Sand</u>	<u>50'</u>	<u>98'</u>

WELL LOCATION:  
sec. 6 T 8 S R 6 E  
IN miles — of PASCAGOULA  
(distance) (direction) (nearest town)

WELL PURPOSE: Home  
(home, irrigation, municipal, industrial)


- WELL COMPLETION DATA:
- (1) diameter (inches) 2"
  - (2) total depth (feet) 98'
  - (3) static water level (feet) 20 <sup>below</sup> ~~above~~ top of ground.
  - (4) casing PVC 88'  
(material) (depth)  
2" if telescope see back.  
(size)
  - (5) screen 10' 88'  
(length) (depth to top)  
2" PVC  
(size) (material)
  - (6) pump 1 1/2 HP 15  
(HP) (yield gpm)  
Electric  
(type power)
  - (7) electric log No  
(yes or no)  
—  
(organization running log)

(8) how well bottom plugged Cash Wash Valve

DRILLERS REMARKS: 1-8-85  
PHD

If well telescopes please sketch and show depths.

GROUND LEVEL

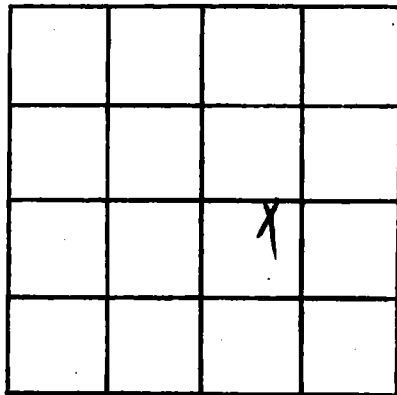

SECTION 6

Please indicate well location X.

ADDITIONAL INFORMATION

If more than one screen,  
show locations of each on sketch.