

MISSISSIPPI DEPARTMENT OF NATURAL RESOURCES

Bureau of Land and Water Resources

Southport Mall

P.O. Box 10631

Jackson, Mississippi 39209

WATER WELL DRILLERS LOG

Jackson
P2111

10-16-1984 Coast Water Well Saw Jackson
 date well completed firm name county well located

LANDOWNER George Boyner
712 West St.
Pascagoula Miss
 (mailing address) 39567

description of formations encountered	from	to
<u>Sandy Topsoil</u>	<u>0</u>	<u>15'</u>
<u>Blue Clay</u>	<u>15'</u>	<u>53'</u>
<u>Coarse Sand</u>	<u>53'</u>	<u>95'</u>

WELL LOCATION:
 sec. 6 T 8 S R. 6 E
IN miles (distance) of PASCAGOULA (direction) (nearest town)

WELL PURPOSE: Home
 (home, irrigation, municipal, industrial)

- WELL COMPLETION DATA:
- (1) diameter (inches) 2"
 - (2) total depth (feet) 95'
 - (3) static water level (feet) 18' ^{below} above top of ground.
 - (4) casing PVC, 85'
 (material) (depth)
 - 2" (size) if telescope see back.
 - (5) screen, 10', 85'
 (length) (depth to top)
 - 2" (size), PVC (material)
 - (6) pump 1 h.p., 15
 (HP) (yield gpm)
 - elec. (type power)
 - (7) electric log No.
 (yes or no)


(organization running log)
 (8) how well bottom plugged Back Wash Valve

DRILLERS REMARKS:

1-8-85
240

If well telescopes please sketch and show depths.

GROUND LEVEL

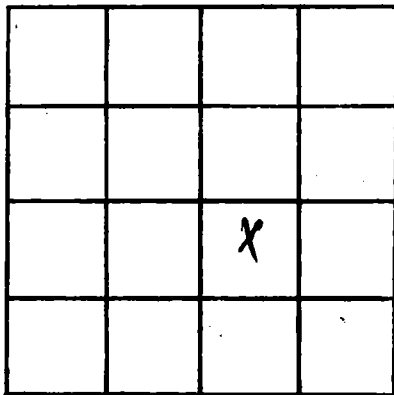

SECTION 6

Please indicate well location X.

ADDITIONAL INFORMATION

If more than one screen, show locations of each on sketch.