

MISSISSIPPI DEPARTMENT OF NATURAL RESOURCES

Bureau of Land and Water Resources

Southport Mall

P.O. Box 10631

Jackson, Mississippi 39209

WATER WELL DRILLERS LOG

Jackson
PH 12

10-26-84 19
date well completed

Coast Water Well Serv. Jackson
firm name

county well located

LANDOWNER:

Herman Brown

description of formations encountered

from

to

4512 7845

Top soil

0 3'

Moss Point, Miss.
(mailing address) 39563

Blue Clay

3 20'

WELL LOCATION:

Blue Clay

20' 43'

sec. 1 T. 7 N. R. 6 W.
1 miles N of ESCATAWPA
(distance) (direction) (nearest town)

Sand & pea gravel

43' 120'

WELL PURPOSE:
(home, irrigation, municipal, industrial)

home

Blue Clay

120' 130'

Sand

130' 201'

WELL COMPLETION DATA:

- (1) diameter (inches) 2"
- (2) total depth (feet) 201'
- (3) static water level (feet) 75' below above-top of ground.
- (4) casing PVC, 191' (material), (depth)
2" (size) If telescope see back.
- (5) screen 10' (length), 191' (depth to top)
2" (size), PVC (material)
- (6) pump 2 h.p. (HP), 9 (yield gpm)
Elev. (type power)
- (7) electric log No. (yes or no)

5'-Tail Pipe

(organization running log)

(8) how well bottom plugged?


Back Wash Valve

1-8-85
J. Paul

DRILLERS REMARKS:

If well telescopes please sketch and show depths.

GROUND LEVEL

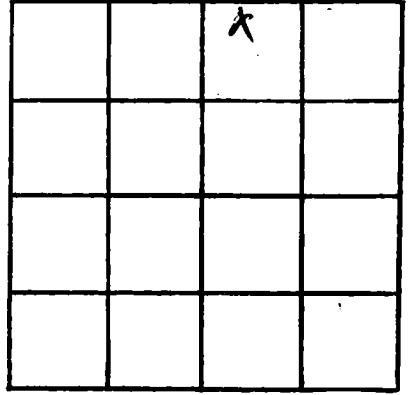

SECTION /

Please indicate well location X.

ADDITIONAL INFORMATION

A series of horizontal lines for writing additional information.

If more than one screen, show locations of each on sketch.