

MISSISSIPPI DEPARTMENT OF NATURAL RESOURCES

Bureau of Land and Water Resources

Southport Mall

P.O. Box 10631

Jackson, Mississippi 39209

WATER WELL DRILLERS LOG

*Jackson*  
P 2113

10-31-84 date well completed *84 Coast Water Well Sew. Jackson* firm name *Jackson* county well located

LANDOWNER:

*B. Caver*  
1118 Resaca De La Palma  
*Pascagoula Missi.*  
(mailing address) *33567*

description of formations encountered

from to

<i>Fine sand</i>	<i>0</i>	<i>14'</i>
<i>Blue Clay</i>	<i>14'</i>	<i>67'</i>
<i>Coarse sand</i>	<i>67'</i>	<i>85'</i>
<i>5' PVC Tail Pipe</i>		

WELL LOCATION:

sec. *6* T. *8* N. R. *6* E.  
*IN* miles of *PASCAGOULA*  
(distance) (direction) (nearest town)

WELL PURPOSE:

*None*  
(home, irrigation, municipal, industrial)

WELL COMPLETION DATA:

- (1) diameter (inches) *2"*
- (2) total depth (feet) *90'*
- (3) static water level (feet) *15'*  below  above top of ground.
- (4) casing *PVC*, *80'*  
(material) (depth)  
*2"* If telescope see back.  
(size)
- (5) screen *10'*, *80'*  
(length) (depth to top)  
*2"* *PVC*  
(size) (material)
- (6) pump *1 hp.*, *15*  
(HP) (yield gpm)  
*Electric*  
(type power)
- (7) electric log *No.*  
(yes or no)

(organization running log)

(8) how well bottom plugged?


*Backwash Valve*

*1-8-85*  
*Jackson*

DRILLERS REMARKS:

If well telescopes please sketch and show depths.

GROUND LEVEL

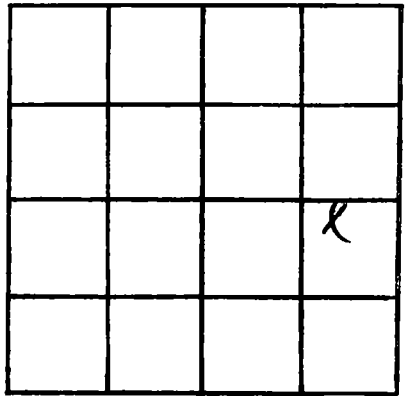

SECTION 6

Please indicate well location X.

ADDITIONAL INFORMATION

If more than one screen,  
show locations of each on sketch.