

MISSISSIPPI DEPARTMENT OF NATURAL RESOURCES

Bureau of Land and Water Resources

Southport Mall

P.O. Box 10631

Jackson, Mississippi 39209

WATER WELL DRILLERS LOG

Jackson
P 2114

10-31-84
date well completed

Coast Water Well Service, Jackson
firm name

county well located

LANDOWNER: *Walter Dady*
4405 Cherubusco St
Pascagoula, Miss
(mailing address) *39567*

description of formations encountered	from	to
<i>Top soil</i>	<i>0</i>	<i>5'</i>
<i>Shay Clay</i>	<i>5'</i>	<i>55'</i>
<i>Coarse sand</i>	<i>55'</i>	<i>90'</i>

WELL LOCATION:
sec. *6* T. *8 N* R. *6 E*
1/4 miles (distance) *W* (direction) of *PASCAGOULA* (nearest town)

Trail Pipe 5' PVC

WELL PURPOSE: *Home*
(home, irrigation, municipal, industrial)

WELL COMPLETION DATA:


- (1) diameter (inches) *2"*
- (2) total depth (feet) *90'*
- (3) static water level (feet) *15'* below top of ground
- (4) casing *PVC* *80'*
(material) (depth)
- 2"* (size) if telescope see back.
- (5) screen *10'* *80'*
(length) (depth to top)
- 2"* (size) *PVC* (material)
- (6) pump *1 HP* *15'*
(HP) (yield gpm)
- check* (type power)
- (7) electric log *No.*
(yes or no)
- (organization running log)
- (8) how well bottom plugged *Back wash valve*

1-8-85
JTD

DRILLERS REMARKS:

If well telescopes please sketch and show depths.

GROUND LEVEL

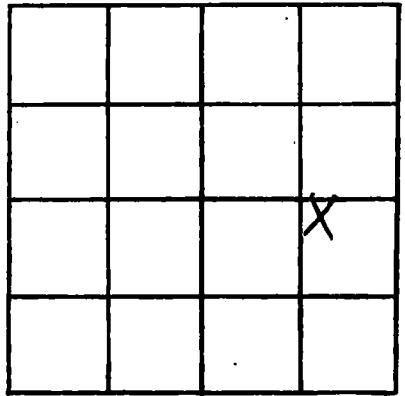

SECTION 6

Please indicate well location X.

ADDITIONAL INFORMATION

If more than one screen, show locations of each on sketch.