

MISSISSIPPI DEPARTMENT OF NATURAL RESOURCES

Bureau of Land and Water Resources

Southport Mall

P.O. Box 10631

Jackson, Mississippi 39209

WATER WELL DRILLERS LOG

JACKSON
P2115

5-29-85

Cross Water Well Sew. Jackson

date well completed

firm name

county well located

LANDOWNER

James Howard

description of formations encountered

from to

1011 Wade Ave.

Top soil

0 2'

Pascagoula Miss. (mailing address) 39267

Blue Clay

2' 35'

WELL LOCATION:

sec. 6 T. 8 N. R. 6 E. IN miles (distance) of PASCOGOLA (direction) (nearest town)

White coarse sand & wood

35' 45'

Blue Clay

45' 57'

WELL PURPOSE:

(home, irrigation, municipal, industrial)

Home

White coarse sand

57' 85'

WELL COMPLETION DATA:

- (1) diameter (inches) 2"
- (2) total depth (feet) 90'
- (3) static water level (feet) 18' below top of ground
- (4) casing PVC 80' (material) (depth)
- 5" (size) if telescope see back.
- (5) screen 10' 80' (length) (depth to top)
- 2" PVC (size) (material)
- (6) pump 1 hp. 15 (HP) (yield gpm)
- Electric (type power)
- (7) electric log No (yes or no)
- (organization running log)

White coarse sand & gravel

85' 90'

5 1/2" Tail Pipe

RECEIVED
JUL 10 1985


DRILLERS REMARKS:

Back well bottom plugged

Department of Natural Resources
Bureau of Land & Water Resources

If well telescopes please sketch and show depths.

GROUND LEVEL

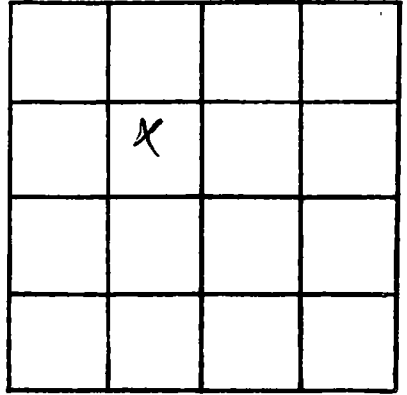

SECTION 6

Please indicate well location X.

ADDITIONAL INFORMATION

If more than one screen, show locations of each on sketch.