

Jackson  
 P 2116  
 5-2-85

MISSISSIPPI DEPARTMENT OF NATURAL RESOURCES  
 Bureau of Land and Water Resources  
 Southport Mall  
 P.O. Box 10631  
 Jackson, Mississippi 39209  
**WATER WELL DRILLERS LOG**

L

5-2-85 19 date well completed  
 Coast Water Well Serv. firm name  
 Jackson county well located

LANDOWNER: Quinn Leath  
 606 Columbus Dr.  
 Pascagoula Miss.  
 (mailing address)

description of formations encountered	from	to
Top soil	0	3'
Red Clay	3'	10'
Blue Clay	10'	40'
White coarse sand	40'	95'
White coarse sand & gravel	95'	173'
Blue Clay	173'	216'
Gray coarse sand	216'	300'

WELL LOCATION:  
 sec. 2 T. 8 N. R. 6 E.  
1N miles of GAULTIER  
 (distance) (direction) (nearest town)

WELL PURPOSE: Home  
 (home, irrigation, municipal, industrial)

WELL COMPLETION DATA:

- diameter (inches) 2"
- total depth (feet) 300'
- static water level (feet) 46' <sup>below</sup> <sub>above</sub> top of ground.
- casing PVC, 290'  
 (material) (depth)  
2" If telescope see back.  
 (size)
- screen 10', 290'  
 (length) (depth to top)  
2" PVC  
 (size) (material)
- pump 1/2 HP, 10  
 (HP) (yield gpm)  
elect.  
 (type power)
- electric log No  
 (yes or no)  
 \_\_\_\_\_  
 (organization running log)
- how well bottom plugged  
Back wash Valve


DRILLERS REMARKS:

**RECEIVED**  
 JUL 11 1985

Department of Natural Resources  
 Bureau of Land & Water Resources

If well telescopes please sketch and show depths.

GROUND LEVEL

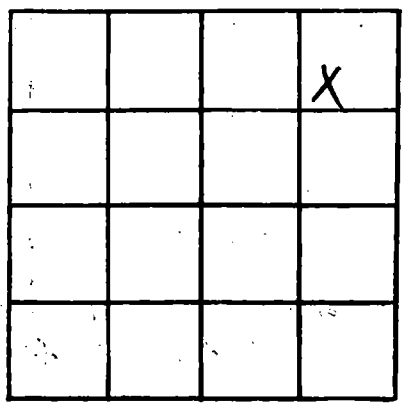

SECTION 2

Please indicate well location X.

ADDITIONAL INFORMATION

A series of 18 horizontal lines for providing additional information.

If more than one screen, show locations of each on sketch.