

MISSISSIPPI DEPARTMENT OF NATURAL RESOURCES

Bureau of Land and Water Resources

Southport Mall

P.O. Box 10631

Jackson, Mississippi 39209

WATER WELL DRILLERS LOG

Jackson
P 217
5-2-85

L

5-2-85
date well completed

Coast Water Well Sew. Jackson
firm name county well located

LANDOWNER: Johan Blankens
701 Old Spanish Trail
Gautier, Miss. 39553
(mailing address)

WELL LOCATION:
sec 2 T. 8 S R. 6 E
1/4 miles of GAUTIER
(distance) (direction) (nearest town)

WELL PURPOSE: Home
(home, irrigation, municipal, industrial)

WELL COMPLETION DATA:
(1) diameter (inches) 2"
(2) total depth (feet) 300'
(3) static water level (feet) 26' ^{below}/_{above} top of ground.
(4) casing PVC 290'
(material) (depth)
2" If telescope see back.
(size)
(5) screen 10' 290'
(length) (depth to top)
2" PVC
(size) (material)
(6) pump L.V.P. 9
(HP) (yield gpm)
Elect.
(type power)
(7) electric log No
(yes or no)
—
(organization running log)

(8) how well bottom plugged
Back Wash Valve

DRILLERS REMARKS:


description of formations encountered	from	to
Top soil	0'	3'
Red Clay	3'	10'
Blue Clay	10'	29'
White Coarse sand	29'	110'
Blue Clay	110'	127'
Gray Coarse sand	127'	160'
Blue Clay	160'	200'
Gray Coarse sand	200'	300'

RECEIVED
JUL 11 1985

Department of Natural Resources
Bureau of Land & Water Resources

If well telescopes please sketch and show depths.

GROUND LEVEL

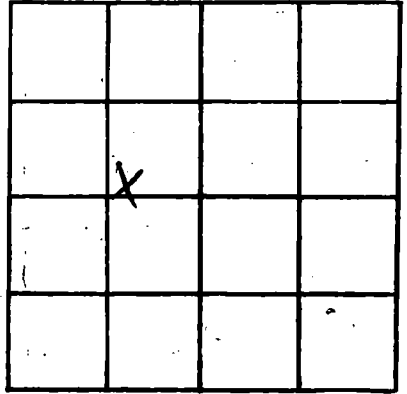

SECTION 2

Please indicate well location X.

ADDITIONAL INFORMATION

Lined area for additional information.

If more than one screen, show locations of each on sketch.