

MISSISSIPPI DEPARTMENT OF NATURAL RESOURCES

Bureau of Land and Water Resources

Southport Mall

P.O. Box 10631

Jackson, Mississippi 39209

WATER WELL DRILLERS LOG

JACKSON

P2118

3-20-85

date well completed

Coast Water Well Serv.

firm name

Jackson

county well located

LANDOWNER:

J.W. Leonard, Jr.

description of formations encountered

from

to

1208 Pascagoula St.
Pascagoula, Miss.
(mailing address) 39567

Top soil

0 2'

Blue Clay

2' 17'

Coarse white sand

17' 40'

Blue Clay w/shell

40' 65'

Coarse white sand

65' 80'

Coarse white sand

80' 105'

5' - Tail Pipe

WELL LOCATION:

sec. 6 T. 8 S. R. 6 E.
1W miles of Pascagoula
(distance) (direction) (nearest town)

WELL PURPOSE:

(home, irrigation, municipal, industrial)

WELL COMPLETION DATA:

- (1) diameter (inches) 2"
- (2) total depth (feet) 105'
- (3) static water level (feet) 15' ^{below} ~~above~~ top of ground.
- (4) casing PVC 95'
(material) (depth)
- 2" if telescope see back.
(size)
- (5) screen 10' 95'
(length) (depth to top)
- 2" PVC
(size) (material)
- (6) pump 1 hp. 15
(HP) (yield gpm)
- Electric
(type power)
- (7) electric log No
(yes or no)

(organization running log)

(8) Lock well bottom plugged
Lock wash valve


DRILLERS REMARKS:

RECEIVED
JUL 10 1985

Department of Natural Resources
Bureau of Land & Water Resources

If well telescopes please sketch and show depths.

GROUND LEVEL

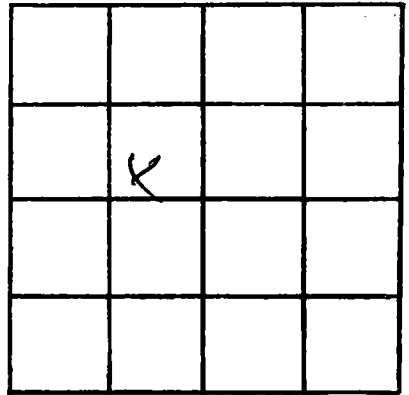

SECTION 6

Please indicate well location X.

ADDITIONAL INFORMATION

If more than one screen,
show locations of each on sketch.